


DATE _____

TOWN OF LEXINGTON — BOARD OF PUBLIC WORKS

WATER DIVISION

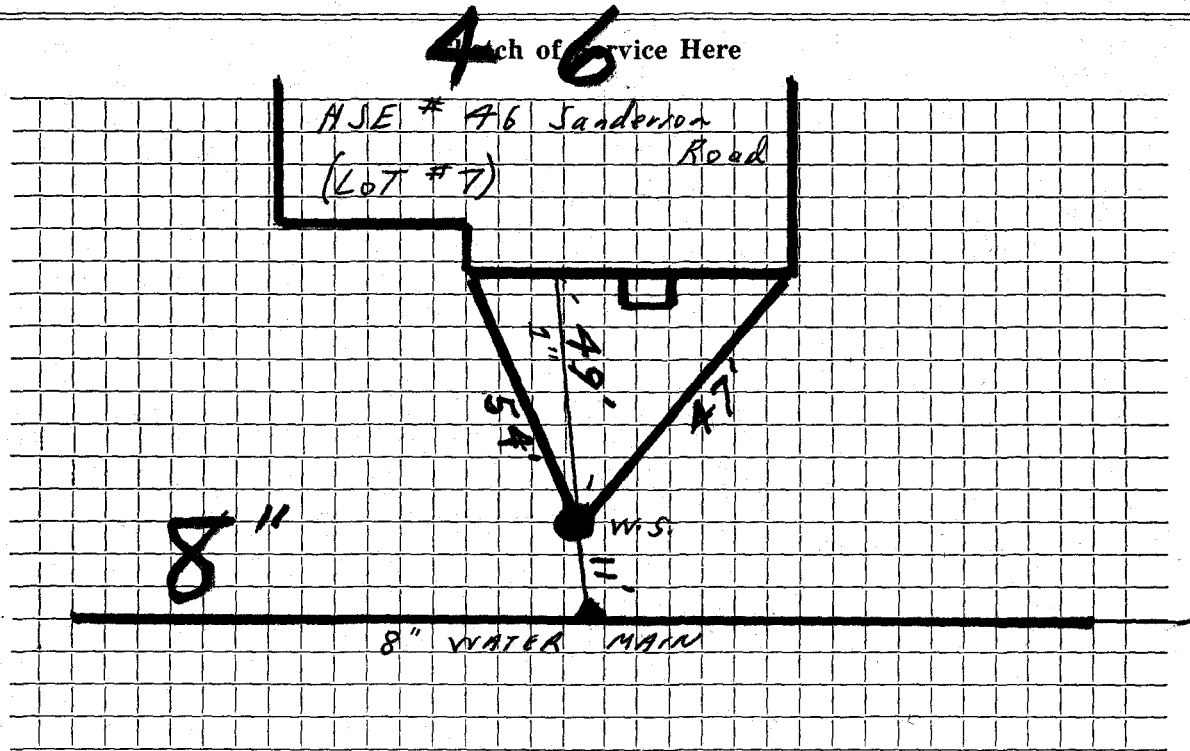

Connection made in Sanderson Road ~~Street~~. Work completed

Remarks:

.....

.....