


TOWN OF LEXINGTON — BOARD OF PUBLIC WORKS

WATER DIVISION

49 Sketch of Service Here

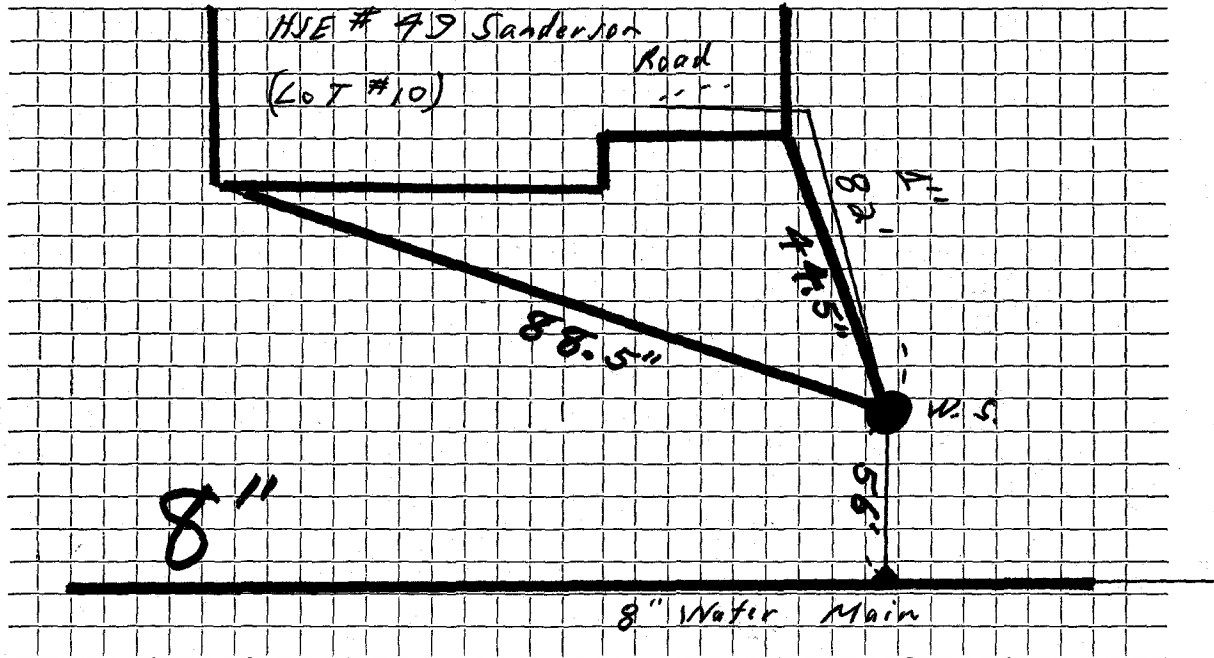

Connection made in Street. Work completed

Remarks:

.....

.....