




DATE \_\_\_\_\_

TOWN OF LEXINGTON — BOARD OF PUBLIC WORKS  
WATER DIVISION

51 Sketch of Service Here

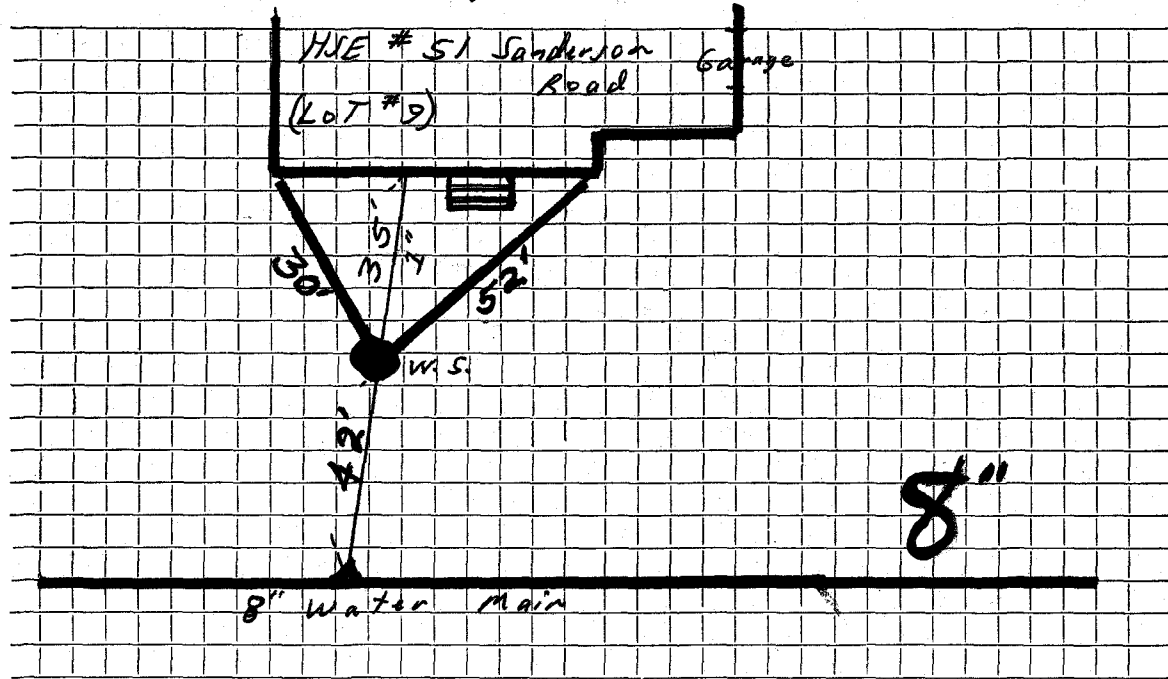

Connection made in ..... Street. Work completed .....

Remarks: .....

.....  
.....