


TOWN OF LEXINGTON — BOARD OF PUBLIC WORKS

WATER DIVISION

Sketch of Service Here

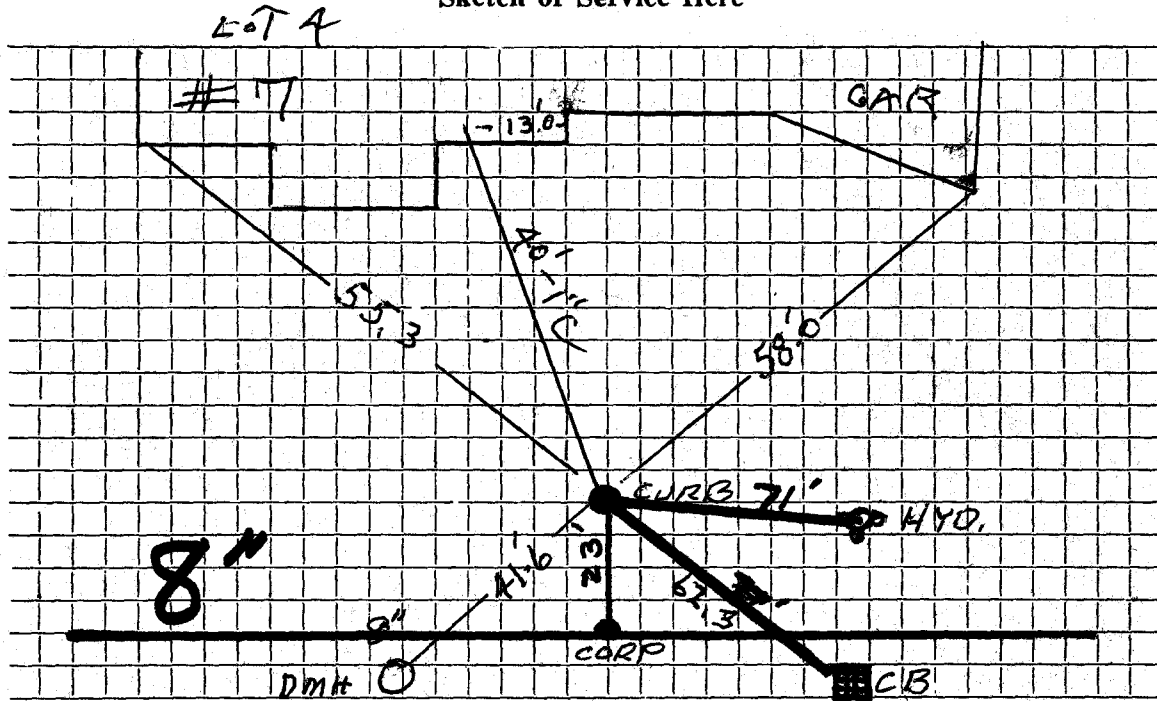

Connection made in SANDERSON RD. Street.

Work completed 7/17/95 J. McLaughlin

Remarks:

.....

.....