


DATE 10/3/89

TOWN OF LEXINGTON — BOARD OF PUBLIC WORKS

WATER DIVISION

Sketch of Service Here

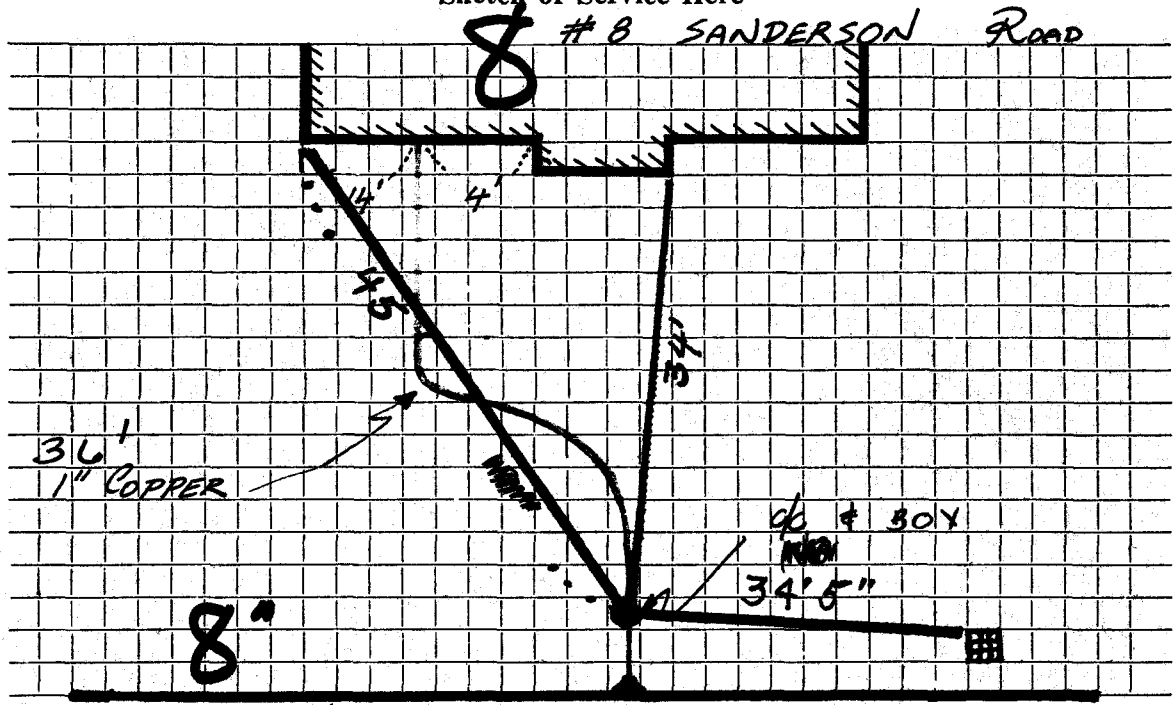

Connection made in SANDERSON Rd. Street. Work completed

Remarks:

.....

.....