




TOWN OF LEXINGTON — BOARD OF PUBLIC WORKS

WATER DIVISION

115 SCHOOL STREET (TIES)

Sketch of Service Here

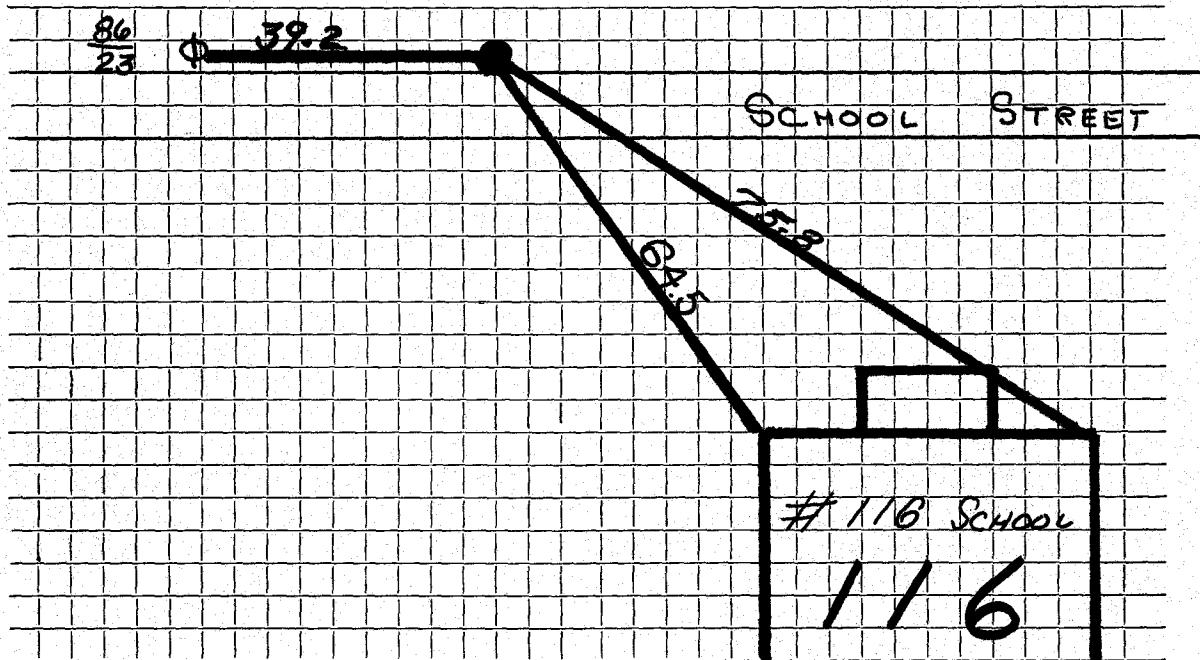

Connection made in ..... Street. Work completed .....

Remarks: .....  
.....  
.....