

WATER SERVICE RECORD

Name

Service No.

Address 120 School ST

Location

LOT 219

Repair—Renewal—New Service

Andressi

Date		Material	Amount		Total	Date		Amount	
9/11/08	9.0	1" Copper							
		1" Corp							
		1" Comb STOP							
		1. bufflo box							
5/25/59	51'	1" copper							
		1x1" S+W							


DATE _____

TOWN OF LEXINGTON — BOARD OF PUBLIC WORKS

WATER DIVISION

Sketch of Service Here

OLD Fudge Funeral home

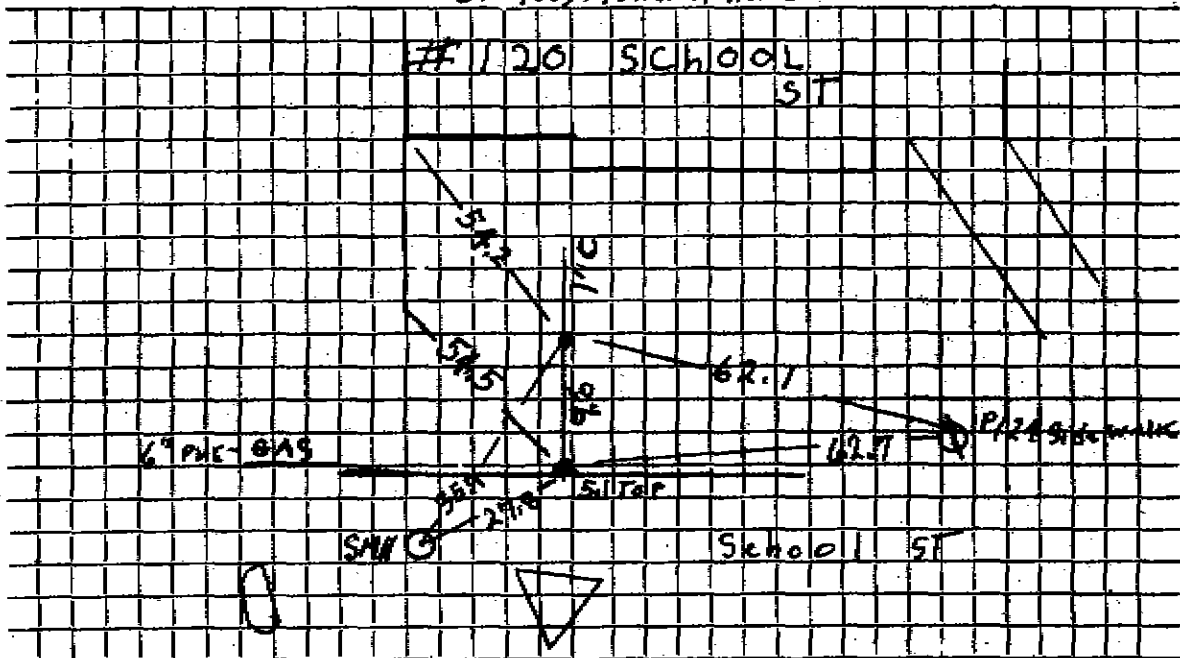

Connection made in School St Street. Work completed 9/11/08

Remarks: Sewer in same Trench
GAS IS DIRECTLY ON TOP OFF WATER MAIN