

Name Josephine H. Smith (Deposit paid by Ernest S. Glawson) Builder.

Service No. ~~50~~ 2410
#7175

Address ~~Hotel Hemenway, Boston,~~

20 School St.

Location 20 School Street

Kind of Pipe

Size

Size of Main

~~HOPEL-12345678~~—New Service

Location

Date	Material	Amount	Total	Date	Amount
1937 6/21/37 <i>am 6/21/37</i>	13 hrs. @ 50¢		6 50	<i>June 16, 1937 Deposited</i>	47 00
	17½ " @ 55¢		9 63		7 04
	2 " @ 60		1 20		39 96
	10% overhead		17 33		
	47' 3/4" Cop. Tub. @ 25¢		1 73		
	1 3/4" S. & W.		11 75		
	1 3/4" C. Union		3 75		
	2 hrs. trucking @ 75¢		1 90		
	Construction Charge		1 50		
			36 96		
			3 00		
			<u>\$39 96</u>		
	Labor				

Hadley Press, Inc., Lexington

DATE June 16, 1937

TOWN OF LEXINGTON—BOARD OF PUBLIC WORKS

WATER DIVISION

The undersigned applies for a supply of water at No. 20 Chapel Street St. and hereby agrees to comply with the rules and regulations as now, or at any future time, established by the Board of Selectmen.

Am't. of Estimate \$ 47⁰⁰

Owner

Josephine H. Smith


Am't. Paid \$ _____

Address

Hotel Hemmaway
Boston

Builder E. S. Glawson

Sketch of Service Here

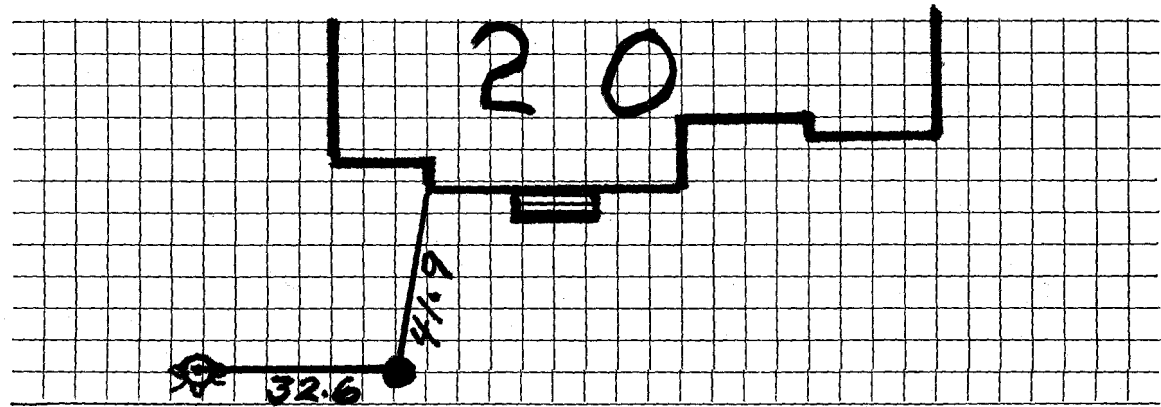

Connection made in _____ Street.

Work completed _____ 19

Remarks: