

Name Frank Licciardi

Service No. 186

Address 26 School Street

2001

Lexington, Mass.

Location 26 School Street

Kind of Pipe

Size

Size of Main

~~Repair~~ ~~Renewal~~ - New Service

Location

Date	Material	Amount	Total	Date	Location	Amount
Sept. 10, '48	Labor	2 30	2 30	Sept 3 48	Deported	20 00
	10% Overhead		23			
	35' - 3/4" Copper Tubing @ .255	8 93	8 93		Non-Charge	
	1 - 3/4" C x 1/2" I.W.H. S & W	3 15	3 15	Sept. 10, '48	Labor	36 06
	Trucking 1 hr. @ .75	75	75	14' - 3/4" Copper Tubing @ .255		3 57
	Patching 5 x 3	5 00	5 00	1 - 3/4" C Corp-cock		3 00
			20 36	1 - 3/4" C x 3/4" C Curb-cock		3 68
				1 - Box & Rod		3 55
				Littlefield Shovel 1 hr. @ 7.00		7 00
				1 - 1/2" Offset Tail Piece		30
	trench dug by owner.			1 - 1/2" Straight Tail Piece		30
				Trucking 1 hr. @ .75		75
	Labor					58 21

Hadley Press, Inc., Lexington

DATE _____

TOWN OF LEXINGTON—BOARD OF PUBLIC WORKS

WATER DIVISION

The undersigned applies for a supply of water at No. _____ St. and hereby agrees to comply with the rules and regulations as now, or at any future time, established by the Board of Selectmen.

Am't. of Estimate \$ _____


Owner _____

Am't. Paid \$ _____

Address _____

Builder _____

Sketch of Service Here

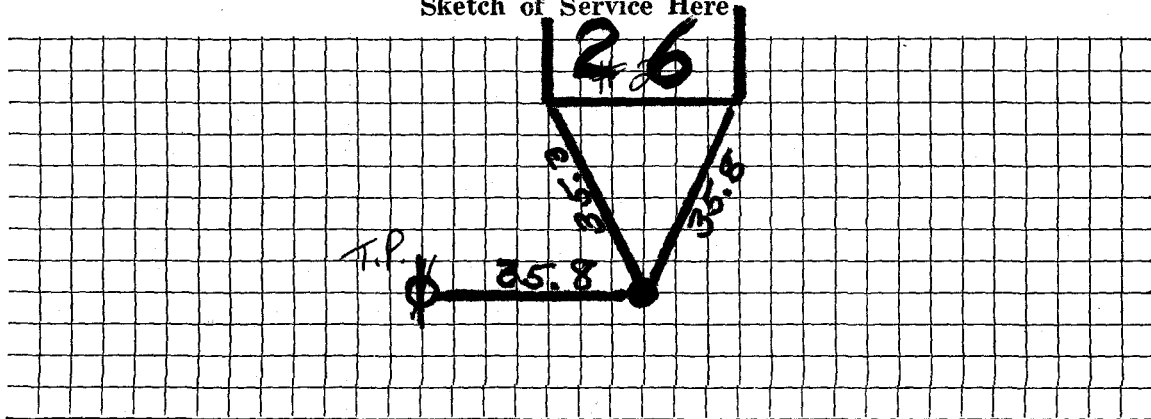

Connection made in _____ Street.

Work completed _____ 19

Remarks: