

Name Joseph Gleason

Service No.

92

Address 32 School Street

Lexington, Mass.

Location 32 School Street

Kind of Pipe

Size

Size of Main

~~REGULAR~~ New Service

Com. 6-14-49

Location

Date	Material	Amount	Total	Date	Amount
May 18, '49	Labor	1 25	1 25	May 11, '49	Deposited 30 00
	10% Overhead		13	June 24 '49	Refunded 7 86
	36' - 3/4" Copper Tubing @.27		9 72		Non-Charge 22 14
	1 - 3/4" C x 1/2" I.W.H. S&W		3 29	May 18, '49	Labor 3 65
	Trucking 1 hr. @.75		75	14' - 3/4" Copper Tubing @.27	3 78
	Patching 7 x 3		7 00	1 - 3/4" C Corp-cock	3 15
			22 14	1 - 3/4" C x 3/4" C Curb-cock	3 85
				2 - 3/4" C x 3/4" C Union(3pts)	2 78
				1 - Box & Rod	3 95
				1 - 1/2" Offset Tail Piece	37
				1 - 1/2" Straight Tail Piece	37
				Littlefield Shovel 2 1/2 hrs. @7.00	17 50
	Labor			Trucking 1 hr. @.75	75
					<u>40 15</u>

TOWN OF LEXINGTON - BOARD OF PUBLIC WORKS

WATER DIVISION

The undersigned applies for a supply of water at No..... St. and hereby agrees to comply with the rules and regulations as now, or at any future time, established by the Board of Selectmen.

Am't of Estimate \$.....

Owner


Am't Paid \$.....

Address

Builder

.....

Sketch of Service Here

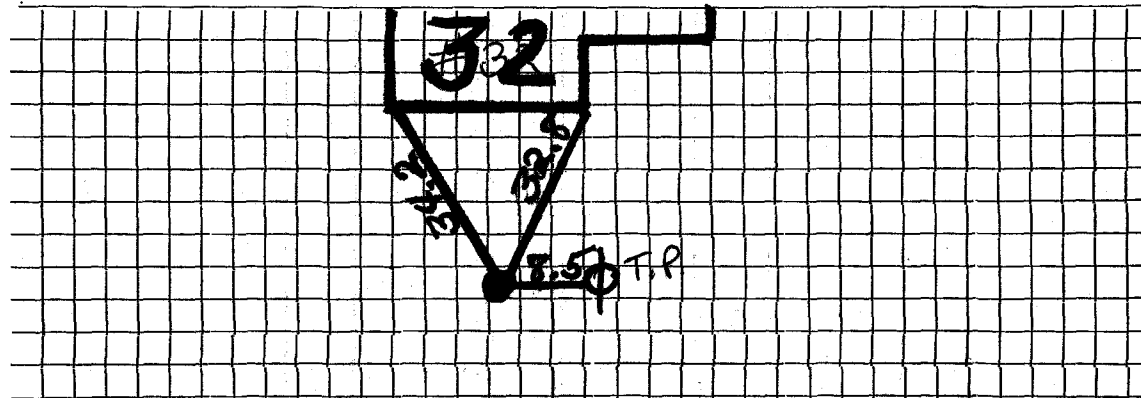

Connection made in Street.

Work completed19

Remarks: