

WATER SERVICE RECORD

#6822

Name Walter Scanlan

Service No. 222

Address 33 School Street, Lexington

1934

Location Mailto: 24 Bromfield Street, Somerville

Repair ~~XXXXXX~~ - New Service

Com. 11-21-55


Date	Material	Amount	Total	Date	Amount
8/22/55	Labor	1 85		7-13-55 Deposited	25 00
	10% Overhead	19	2 04	11-21-55 Paid	24
	50'-3/4" Copper tubing @.384	19 20		Non Charge	25 24
	1-3/4" Cx 1/2" I.W.H. stop & waste	4 00	8/22/55	Labor	1 85
			25 24	18'-3/4" C Copper tubing @.384	6 91
				1-3/4" C Corp cock	4 33
				1-3/4" Cx 3/4" C Curb cock	4 67
				1 Box & Rod	3 90
				1-1/2" straight tail piece	50
				1-1/2" offset tail piece	50
					22 66

DATE _____

TOWN OF LEXINGTON — BOARD OF PUBLIC WORKS

WATER DIVISION

Sketch of Service Here

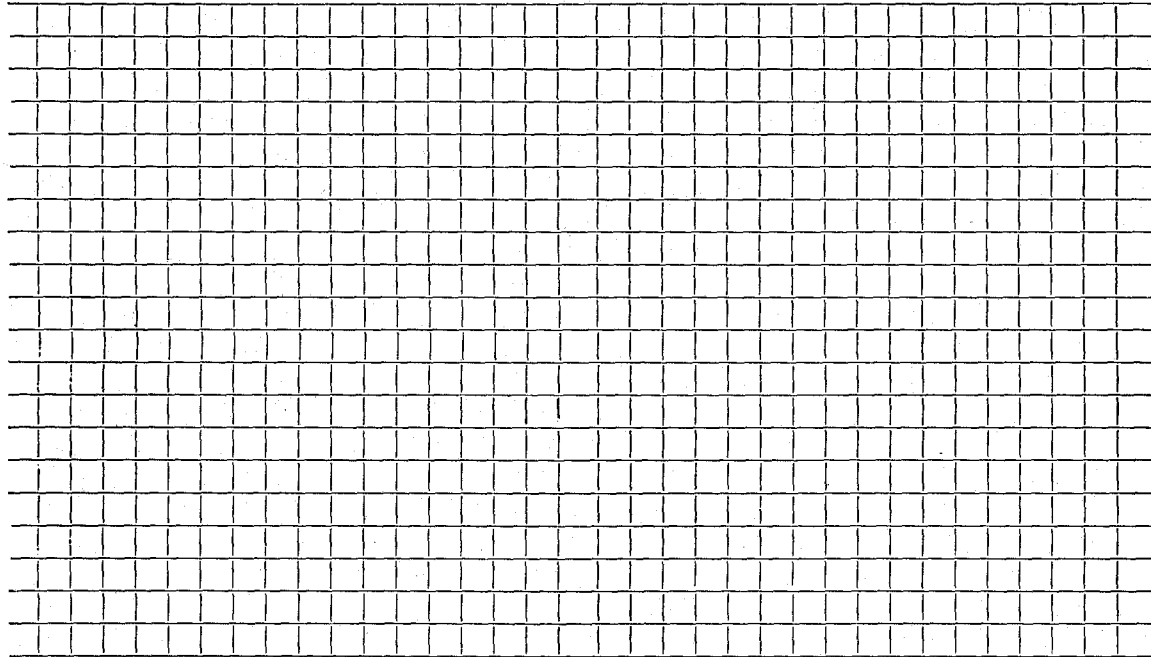

Connection made in Street. Work completed

Remarks:

.....

.....