

Name Harold W. Demone, Jr.

1285 Service No. 162

Address 41 School Street

Lexington, Mass.

Location 41 School Street

Kind of Pipe

Size

Size of Main

~~Repair or Renewal~~ - New Service

Com. 9-5-50

Location

Date	Material	Amount	Total	Date	Amount
Jul. 22, '50	Labor	5 20	5 20	July 11 '50	Reported
	10% Overhead		52		
	121' - 3/4" Copper Tubing @.23	27 83			No Charge
	1 - 3/4"C x 1/2" I.W.H. S&W	3 29		Jul. 22, '50	Labor
	2 - 3/4"C x 3/4"C Unions (3pts)	2 78			15' - 3/4" Copper Tubing @.23
	Littlefield Shovel 4 hrs. @ 7.00	28 00			1 - 3/4"C Corp-cock
	Trucking 1 hr. @.75	75			1 - 3/4"C x 3/4"C Curb-cock
	Patching 11 x 3		11 00		1 - Box & Rod
			79 37		1 - 1/2" Offset Tail Piece
					1 - 1/2" Straight Tail Piece
					Littlefield Shovel 2 hrs. @ 7.00
					Trucking 1 hr. @.75
	Labor				52 51

DATE \_\_\_\_\_

# TOWN OF LEXINGTON—BOARD OF PUBLIC WORKS

## WATER DIVISION

The undersigned applies for a supply of water at No. \_\_\_\_\_ St. and hereby agrees to comply with the rules and regulations as now, or at any future time, established by the Board of Selectmen.

Am't. of Estimate \$ \_\_\_\_\_


Owner \_\_\_\_\_

Am't. Paid \$ \_\_\_\_\_

Address \_\_\_\_\_

Builder \_\_\_\_\_

Sketch of Service Here

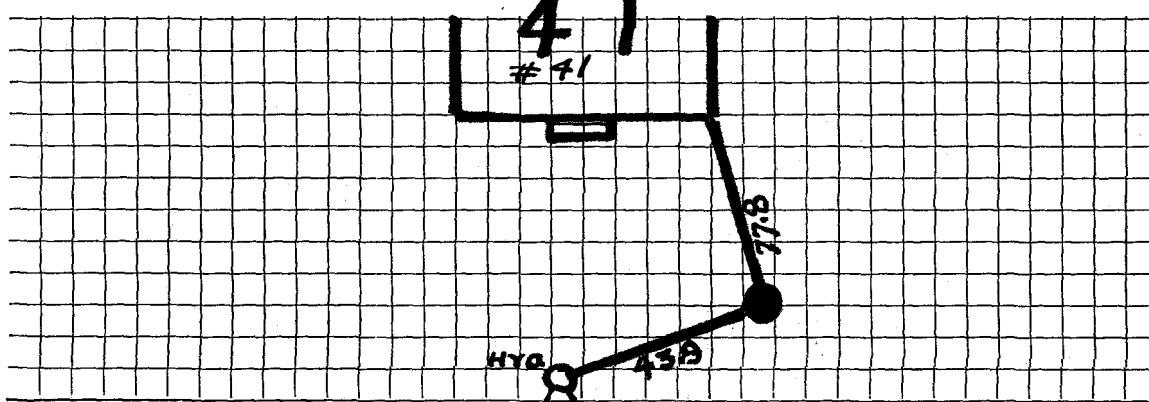

Connection made in \_\_\_\_\_ Street.

Work completed \_\_\_\_\_ 19

Remarks: