

Name Jesse Souza

Service No. ~~50~~ 2412

Address 42 School St., Lexington

Send any refund to:
Credit Union, Boston & Maine R.R.
No. Sta. Boston

Location 42 School St.,

Kind of Pipe

Size

Size of Main

~~Repair~~ - New Service

Location

Date 1942	Material Chargeable	Amount	Total	Date	Amount
June 15,	9 hrs. @ 60¢	5 40		June 10, 1942	100 ^{ad}
<i>Com 7/6/42</i>	11 " @ 65¢	7 15		July 16, 1942	8.19
	4 " @ 70¢	2 80	15 35		
	10% Overhead		1 54		91 81
	245' 1" C.L. Pipe @ 23¢		56 35	<u>Curb to Main. Not Chargeable</u>	
	12' 3/4" Copper tubing @ 21¢		2 52	Labor	10 20
	1 1" I x 3/4" I.W.H.S. & W.		2 55	8' 3/4" Copper tubing @ 21¢	1 68
	11 1" L.L. Couplings @ 21¢		2 31	1 3/4" Copper Corp. cock	2 25
	1 1" I x 3/4" C. Union		1 26	1 3/4" " Curb cock	2 75
	2 1" L.L. Elbows @ 15¢		30	2 3/4" I x 3/4" C Bends	1 15
	1 1" Brass Close Nipple		10	2 3/4" Straight Tail Pieces @ .38	76
	2' 22" Clay pipe @ 1.15		2 30	1 Box and Rod	1 65
	1 Pit cover & Frame		3 93	1 hr. compressor @ 2.25	2 25
	2 hrs. trucking @ 75¢		1 50	1 " trucking	75
	Labor		90 01		23 44
	Trench repairs		1 80		
			91 81		

Hadley Press, Inc., Lexington

DATE April 17, 1942

TOWN OF LEXINGTON—BOARD OF PUBLIC WORKS
WATER DIVISION

The undersigned applies for a supply of water at No. 42 School St. and hereby agrees to comply with the rules and regulations as now, or at any future time, established by the Board of Selectmen.

Am't. of Estimate \$ 100⁰⁰


Owner Jesse Samza

Am't. Paid \$ _____

Address 42 School St.

Builder _____

Sketch of Service Here

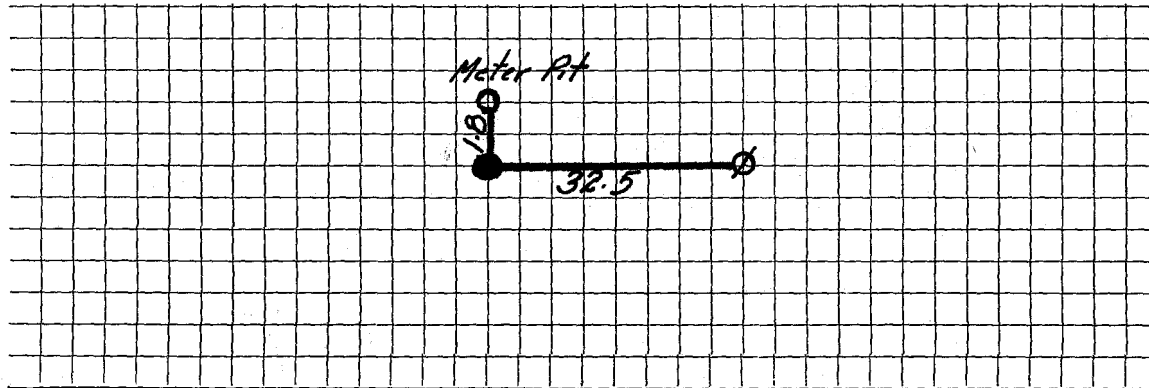

Connection made in _____ Street.

Work completed _____ 19

Remarks: