

Name Hugh Clarke

Service No.

109

Address 44 School Street

3666

Lexington, Mass.

Location 44 School Street

Kind of Pipe

Size

Size of Main

~~Repair~~ - ~~Renewal~~ - New Service

Location

Date	Material	Amount	Total	Date	Amount
Aug. 9, '48	Labor	3 25	3 25	July 15 '48	35 00
	10% Overhead		33		
	26' - 3/4" Copper Tubing @ .255		6 63		
	1 - 3/4" 3 x 1/2" I.W.H. S & S		3 15		
	Shovel 2 hrs. @ 7.00		14 00	Aug. 9, '48	5 45
	Trucking 1 hr. @ .75		75	15' - 3/4" Copper Tubing @ .255	3 83
	Patching 6 x 3		6 00	1 - 3/4" Corp-cock	3 00
			34 11	1 - 3/4" 3 x 3/4" Curb-cock	3 68
				1 - Box & Rod	3 55
				1 - 1/2" Offset Tail Piece	30
				1 - 1/2" Straight Tail Piece	30
				Littlefield Shovel 1 hr. @ 7.00	7 00
				Trucking 1 hr. @ .75	75
	Labor				27 86

Deposited

Non-Charge

DATE _____

TOWN OF LEXINGTON—BOARD OF PUBLIC WORKS

WATER DIVISION

The undersigned applies for a supply of water at No. _____ St. and hereby agrees to comply with the rules and regulations as now, or at any future time, established by the Board of Selectmen.

Am't. of Estimate \$ _____


Owner _____

Am't. Paid \$ _____

Address _____

Builder _____

Sketch of Service Here

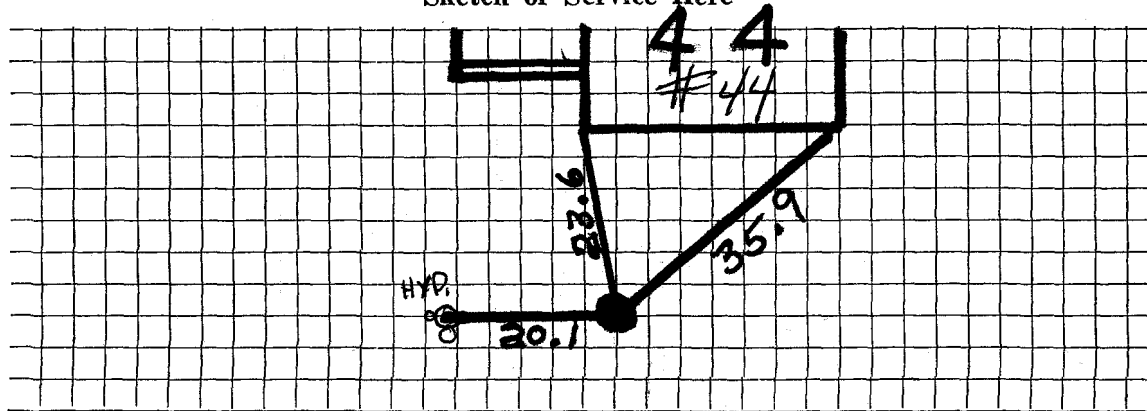

Connection made in _____ Street.

Work completed _____ 19

Remarks: