

Name ~~Hugh Clarke~~

Service No.

172

34/2

Address 50 School Street

Location 50 School Street

Kind of Pipe

Size

Size of Main

~~REPAIR SERVICE~~ - New Service

Com 12/31/47

Location

Date	Material	Amount	Total	Date	Amount
Oct. 10, '47	Labor	2 05	2 05	Feb 6 '48	30 48
	10% Overhead		21		
	32' - 3/4" Copper Tubing @.26		8 32		Non-Charge
	1 - 3/4" C x 1/2" I.W.H. S & W		3 15	Oct. 10, '47	Labor 1 10
	Hired Shovel 1 hr. @ 7.00		7 00		15' - 3/4" Copper Tubing @.26 3 90
	Patching 9 x 3		9 00		1 - 3/4" C Corp-cock 3 00
	Trucking 1 hr. @ .75		75		1 - 3/4" C x 3/4" C Curb-cock 3 68
			30 48		1 - Box & Rod 4 26
					1 - 1/2" Straight Tail Piece 30
					1 - 1/2" Offset Tail Piece 30
					Trucking 1 hr. @.75 75
					17 29
	Labor				

Bill sent 1/8/48

DATE _____

TOWN OF LEXINGTON - BOARD OF PUBLIC WORKS

WATER DIVISION

The undersigned applies for a supply of water at No..... St. and hereby agrees to comply with the rules and regulations as now, or at any future time, established by the Board of Selectmen.

Am't of Estimate \$.....

Owner


Am't Paid \$.....

Address

Builder

22 Prescott St. Medford Mass

Sketch of Service Here

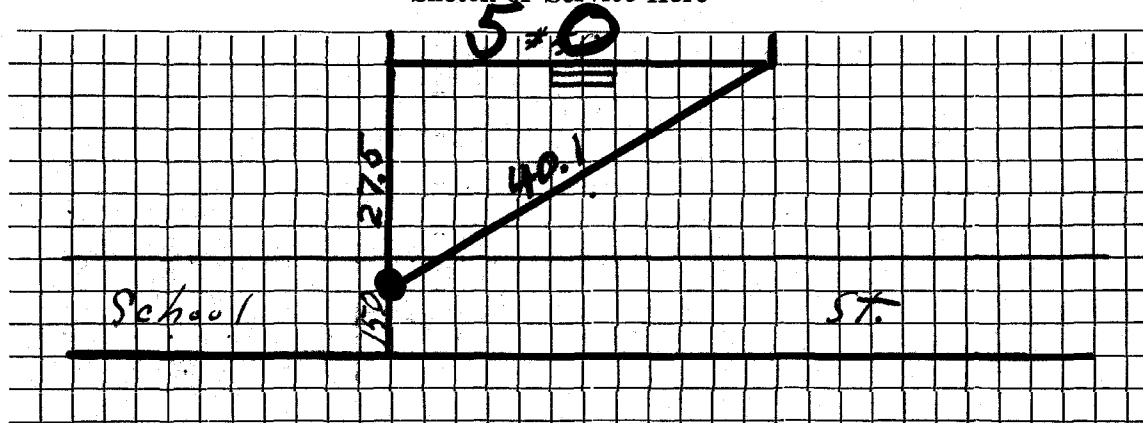

Connection made in Street.

Work completed19

Remarks: