


DATE _____

TOWN OF LEXINGTON — BOARD OF PUBLIC WORKS WATER DIVISION

Sketch of Service Here

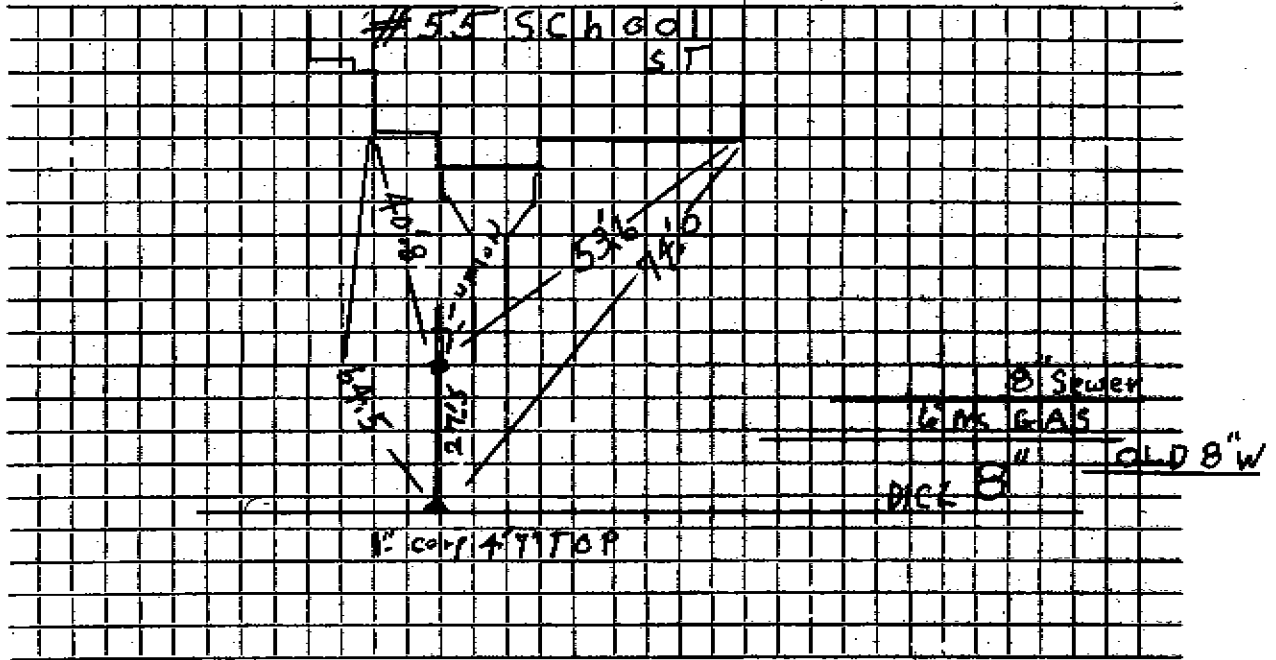

Connection made in School St New W.M. Street.

Work completed 8/28/08. Address.....

Remarks:
.....
.....