




DATE \_\_\_\_\_

TOWN OF LEXINGTON — BOARD OF PUBLIC WORKS

WATER DIVISION

Sketch of Service Here

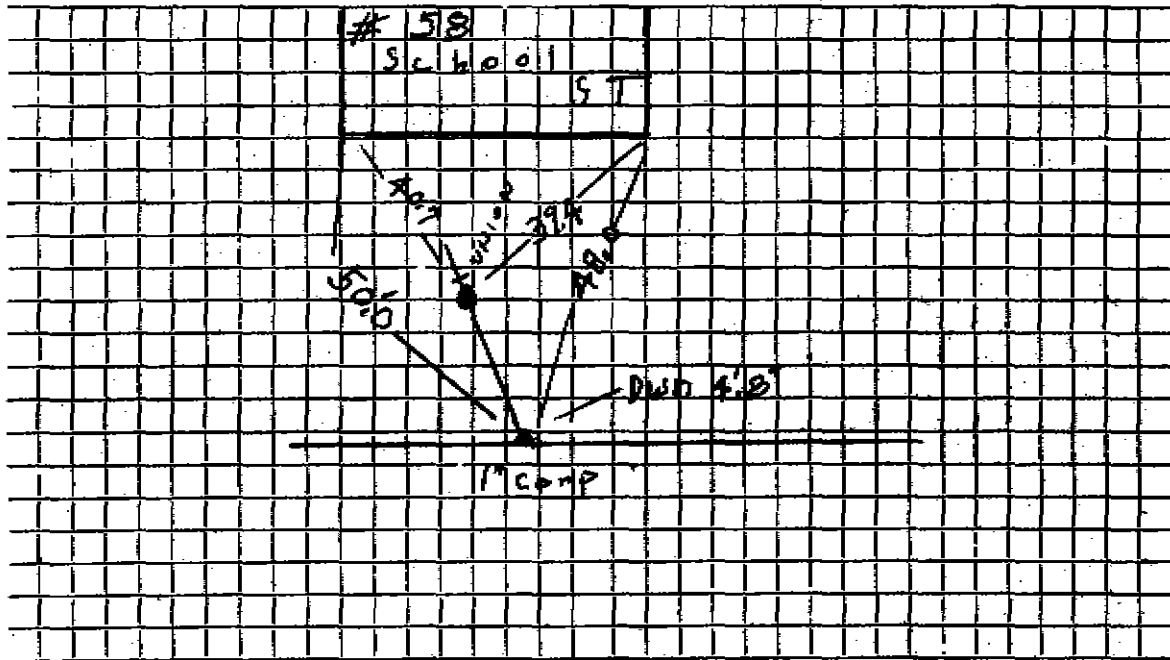

Connection made in School St Street. Work completed .....

Remarks: 1" x 3/4 Union 100' from cur. .....