

WATER SERVICE RECORD

Name E.R. Stockdale

Service No. 105

Address 6 School Street

Location

Repair ~~Renewal~~ ~~New Service~~ *Renewal*

*Comm. 10-8-56*


Date	Material	Amount	Total	Date	Amount	
7/8/56	Labor	1 76		5-17-56	Deposit	50 00
	10% Overhead	18	1 94	10-8-56	Refund	1 10
	50' 3/4 Coppertubing @.4850		24 25			31 70
	1 3/4" Cx 1/2 I.W.H. Stop & Waste		4 96			
	1 hr. trucking		75		NON CHARGE	
			31 90		Labor	1 76
					10 3/4" Coppertubing.4850	4 85
					1 3/4" Corp. Cock	4 64
					1 3/4" Curb "	5 94
					1 Box & Rod	4 62
					1 1/2 Straight Tail Piece	50
					1 1/2 Offset " "	50
						22 81

DATE \_\_\_\_\_

TOWN OF LEXINGTON — BOARD OF PUBLIC WORKS

WATER DIVISION

Sketch of Service Here

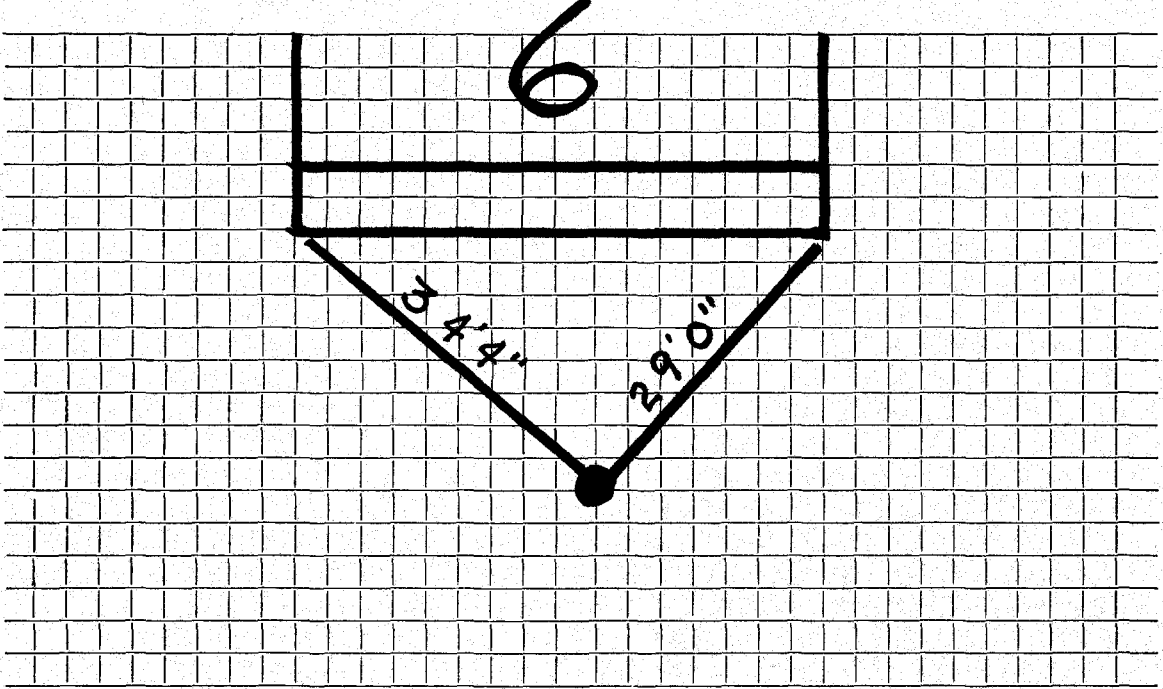

Connection made in ..... Street. Work completed .....

Remarks: *Original Service 10-10-30* .....

.....  
.....