


DATE _____

TOWN OF LEXINGTON — BOARD OF PUBLIC WORKS

WATER DIVISION

Sketch of Service Here

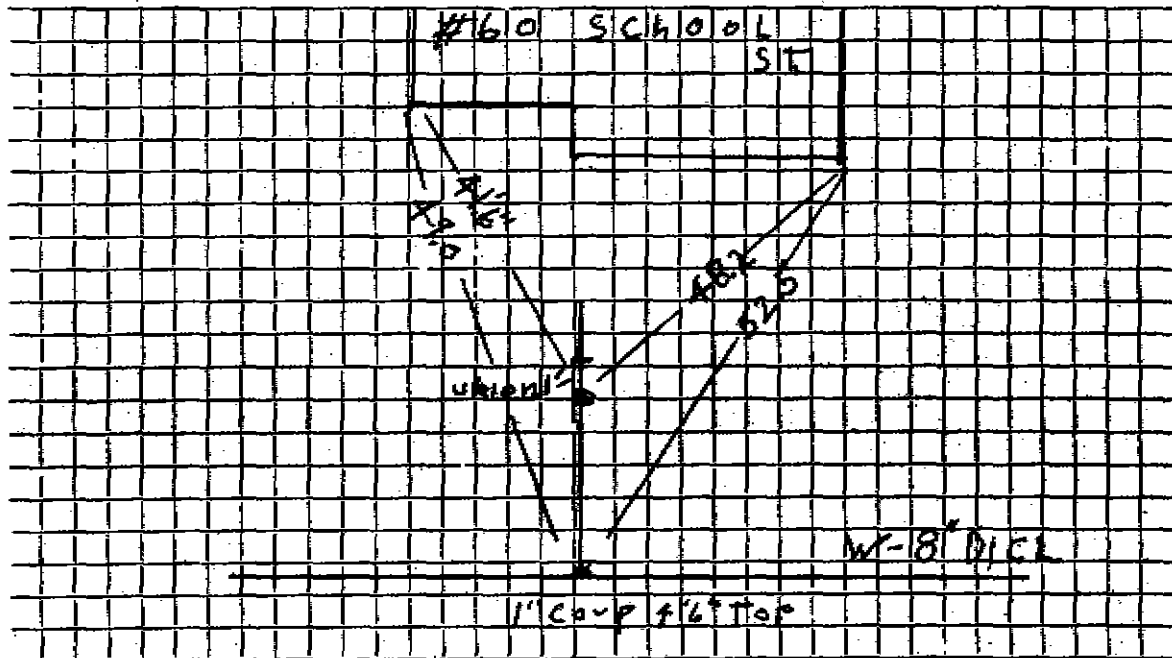

Connection made in School St Street. Work completed 8/27/08 Andreas S.S.I.

Remarks:

.....

.....