


DATE _____

TOWN OF LEXINGTON — BOARD OF PUBLIC WORKS

WATER DIVISION

Sketch of Service Here

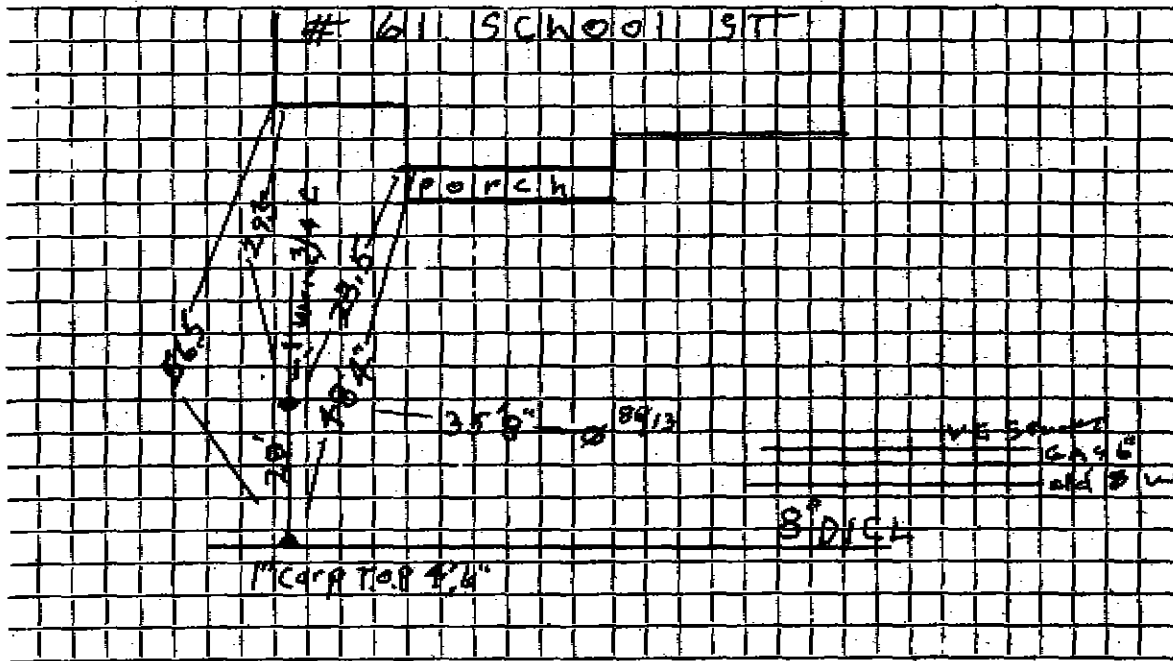

Connection made in Street. Work completed 8/28/08 ANDY SASSI.....

Remarks: NEW 8" PVC SEWER MAIN