




DATE 1/15/19

TOWN OF LEXINGTON — BOARD OF PUBLIC WORKS

WATER DIVISION

Sketch of Service Here

# 69

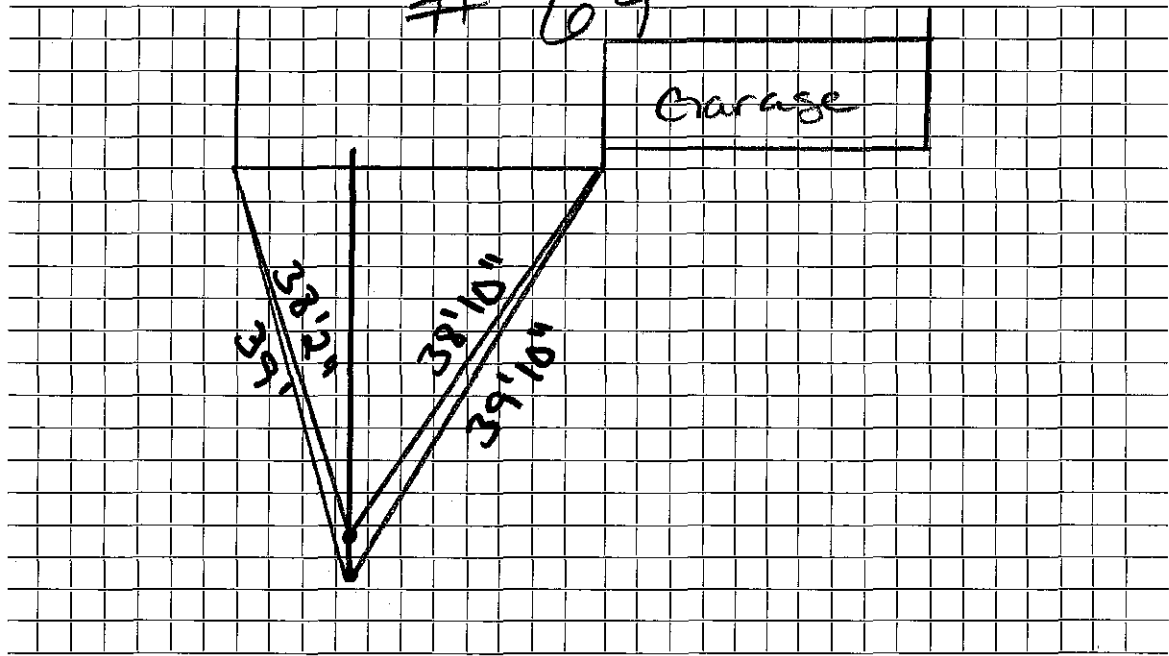

Connection made in ... School ... Street. Work completed .....

Remarks: .....