


DATE _____

TOWN OF LEXINGTON — BOARD OF PUBLIC WORKS

WATER DIVISION

Sketch of Service Here

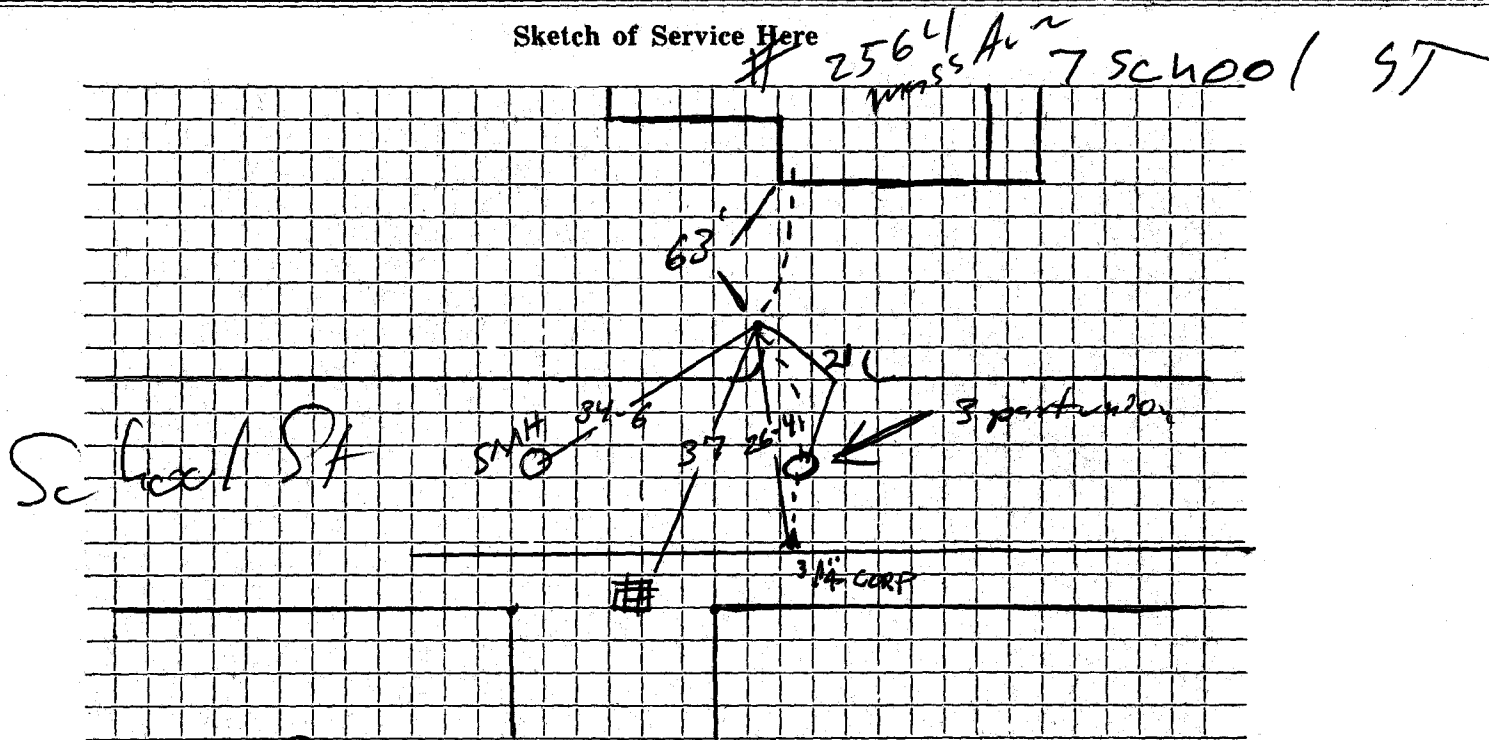

Connection made in School St Street. Work completed

Remarks: 3/4 corp 3'-4" 3/4 copper 1" copper to house