




DATE \_\_\_\_\_

**TOWN OF LEXINGTON — BOARD OF PUBLIC WORKS**

**WATER DIVISION**

Sketch of Service Here

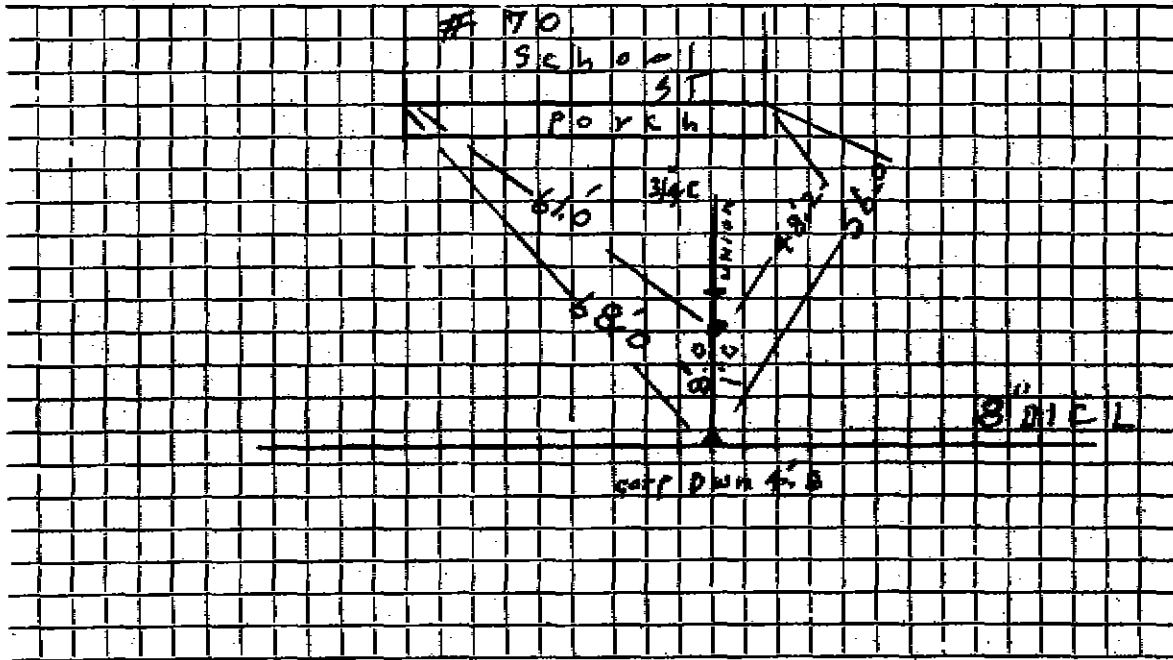

Connection made in ..... Street.

Work completed 7/2/08 Andrew S.S......

Remarks: .....

.....

.....