


DATE _____

TOWN OF LEXINGTON — BOARD OF PUBLIC WORKS

WATER DIVISION

Sketch of Service Here

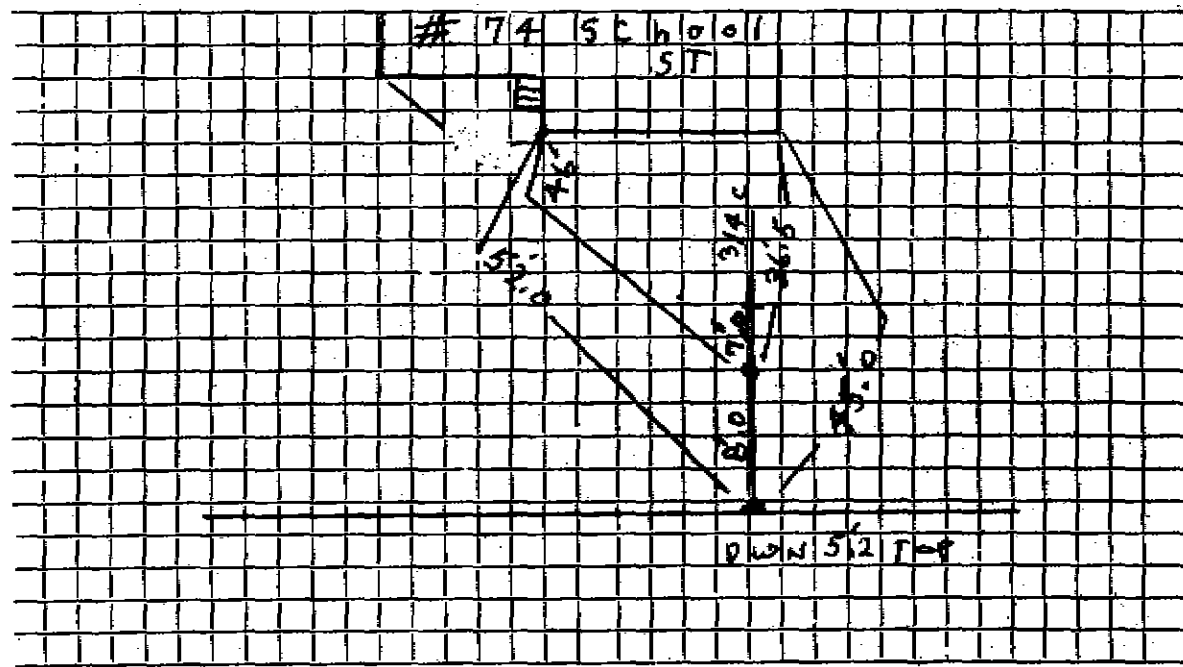

Connection made in _____ Street

Work completed 9/2/08

Remarks: Curb Stop To 1274 Union T.O.