

WATER SERVICE RECORD

Name

Service No.

Address 88 School ST

Location

Lot 135

Repair—Renewal—New Service


Andover

Date	Material	Amount	Total	Date	Amount
9/8/08	11' 1" Copper				
	1" Corp				
	1" Curb Stop				
	1" x 3/4 Union				
	buffle box				
Existing					
6/5/53	40' 3/4 Copper				
	1 3/4 Union G-3 Part				
	3/4 x 1/2 S&W				

DATE _____

TOWN OF LEXINGTON — BOARD OF PUBLIC WORKS
WATER DIVISION

Sketch of Service Here

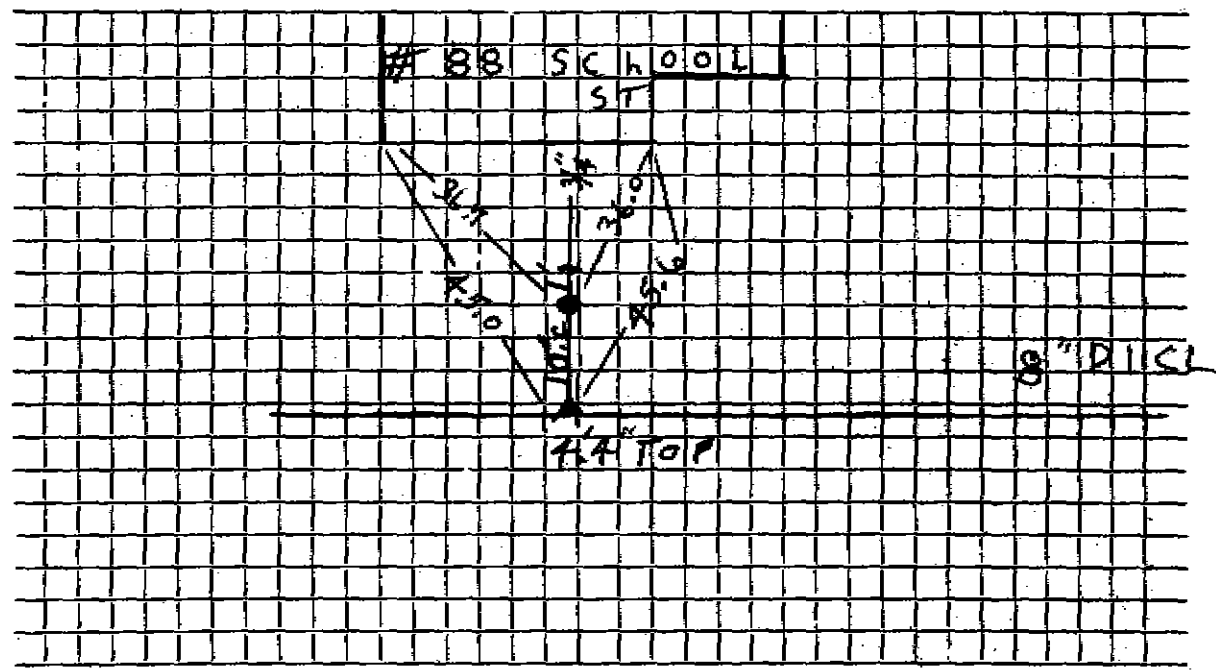

Connection made in Street. Work completed 9/8/08

Remarks:
.....
.....