

Name Mr. F. Bougie

Service No. 779

Address

~~Eastern Avenue~~ School Street

~~Eastern Avenue~~

Location Eastern Avenue

Kind of Pipe

Size

Size of Main

Repair - Renewal - New Service

Location

Date

Material

Amount

Total

Date

Amount

6/1/32

3' 1" C.L. Pipe @ .27

51

Comm. 11.26

1 1"x1/2" L.L. Coup.

17

May 31 1932 - Cash

10 -

6-21-32

Trucking

75

1 43

June 29 1932 - Cash

1 26

7 Hrs. Labor @ .60

4 20

15% Overhead

63

4 83

Charge for building pit

5 00

11 26

Labor

DATE May 16, 1932

TOWN OF LEXINGTON—BOARD OF PUBLIC WORKS

WATER DIVISION

The undersigned applies for a supply of water at No. Eastern Ave. and hereby agrees to comply with the rules and regulations as now, or at any future time, established by the Board of Selectmen.

Am't. of Estimate \$ _____

Owner

G. J. Bourgie


Am't. Paid \$ _____

Address

School Street
Town

Builder _____

Sketch of Service Here

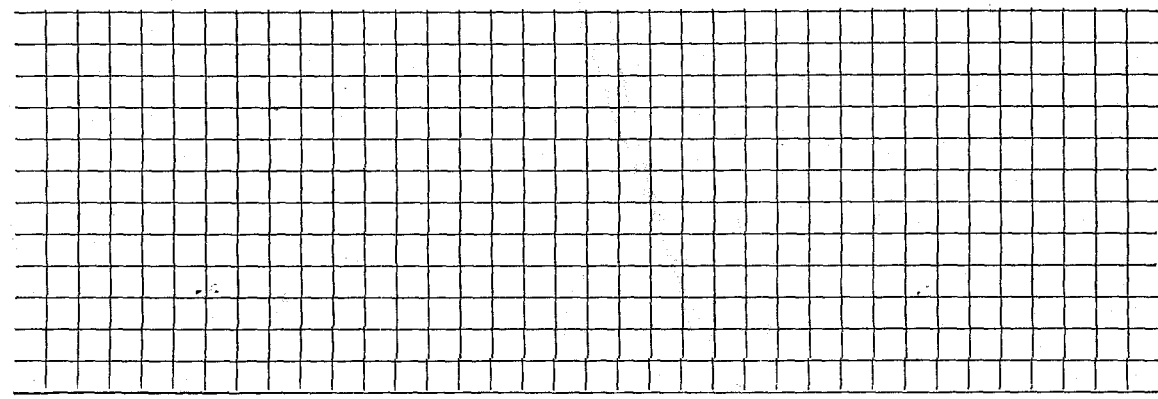

Connection made in _____ Street.

Work completed _____ 19

Remarks:

Name *Thompson*

Service No. *2409*

Address *Mass. Ave.
School St.*

Location *School St. (Garden)*

Kind of Pipe

Size

Size of Main

Repair—Renewal—New Service

Location

Date	Material	Amount	Total	Date	Amount
	Labor				

DATE _____

TOWN OF LEXINGTON—BOARD OF PUBLIC WORKS

WATER DIVISION

The undersigned applies for a supply of water at No. _____ St. and hereby agrees to comply with the rules and regulations as now, or at any future time, established by the Board of Selectmen.

Am't. of Estimate \$ _____

Owner

Thompson


Am't. Paid \$ _____

Address

School St

Builder _____

(Garden)

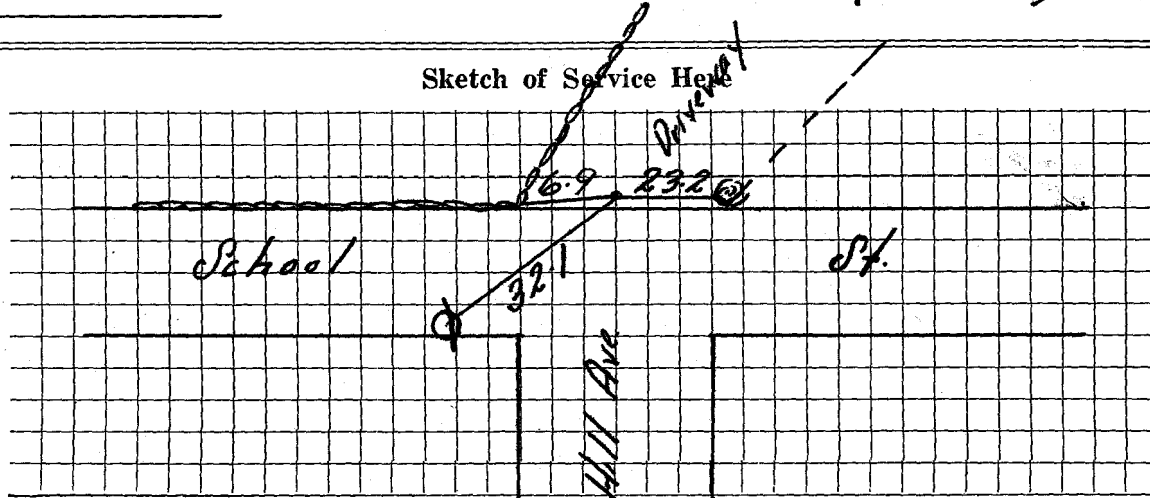

Connection made in _____

Street.

Work completed _____

19

Remarks: