

WATER SERVICE RECORD

#4150

Name Kelly Corp.

Service No. 252

Address 1 Scotland Road

Location Lexington

~~Repair/ Renewal~~ - New Service

*Com. 12-1-52*


Date	Material	Amount	Total	Date	Amount
10/29/52	Labor	1 63		10-9-52	Deposited 10 -
	10% overhead	16	1 79	12-1-52	Refunded (9 46)
	1 -3/4" C x 1/2 I.W.H. stop & waste	4 00			NON CHARGE 6 54
	1 hr. trucking		75	10/29/52	Labor 3 14
			6 54	27' - 3/4" copper tubing @ .34	9 18
	TRENCH DUG BY OWNER			1 -3/4" C. corp-cock	4 33
	PIPE SUPPLIED & LAID BY OWNER			1 -3/4" Cx 3/4" C. curb-cock	4 67
				1 box and rod	3 90
				1 -1/2 offset tail pc.	50
				1 -1/2 straight tail pc.	50
				1 hr. trucking	75
					<u>28 97</u>

DATE \_\_\_\_\_

TOWN OF LEXINGTON — BOARD OF PUBLIC WORKS

WATER DIVISION

Sketch of Service Here

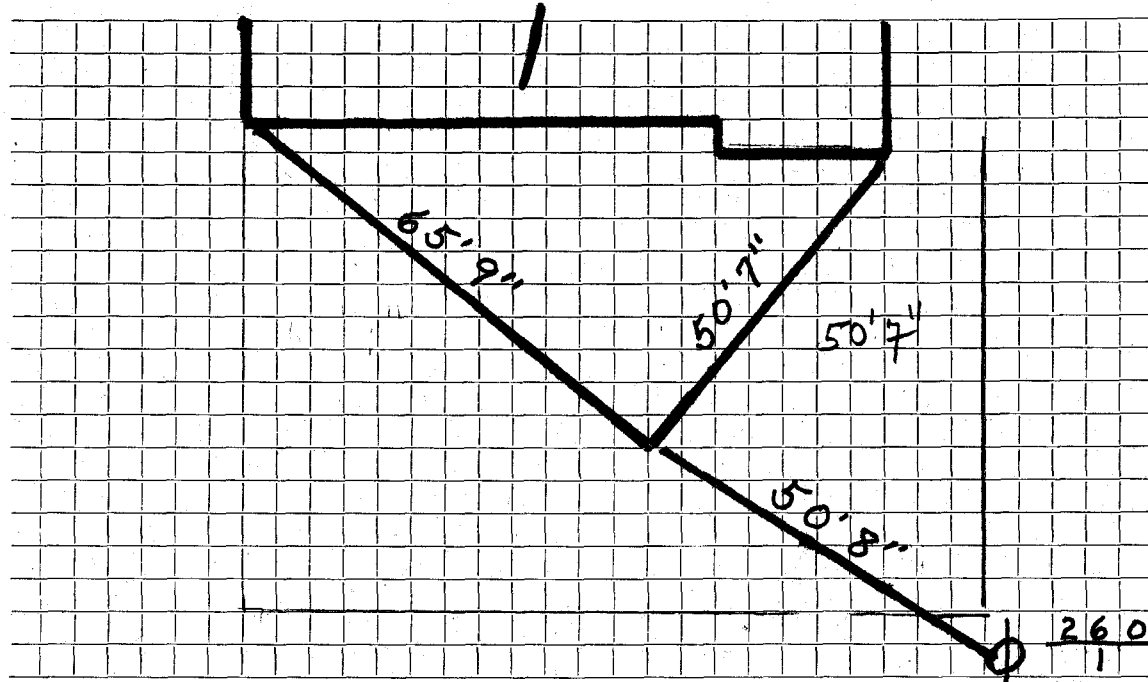

Connection made in ..... Street. Work completed .....

Remarks: .....  
.....  
.....