

WATER SERVICE RECORD

Name Kelly Corp.

Service No. 259

Address 10 Scotland Rd.

Location Lexington

~~Repair/Replacement~~ - New Service

Com 12-1-52


Date	Material	Amount	Total	Date	Amount
10/31/52	Labor	1 63		10-9-52 Deposited	10 -
	10% overhead	16	1 79	12-1-52 Refunded	6 46
	1 -3/4" C x 1/2 I.W.H. stop & waste	4 00	4 00	NON CHARGE	6 54
	1 hr. trucking		75	10/31/52 Labor	4 74
			6 54	17' - 3/4" copper tubing @ .34	5 78
	TRENCH DUG BY OWNER			1 -3/4" C. corp-cock	4 33
	PIPE SUPPLIED & LAID BY OWNER			1 -3/4" Cx 3/4" C. curb-cock	4 67
				1 box and rod	3 90
				1 -1/2 straight tail pc.	50
				1 -1/2 offset tail pc.	50
				1 hr. trucking	75
					<u>25 17</u>

DATE _____

TOWN OF LEXINGTON — BOARD OF PUBLIC WORKS

WATER DIVISION

Sketch of Service Here

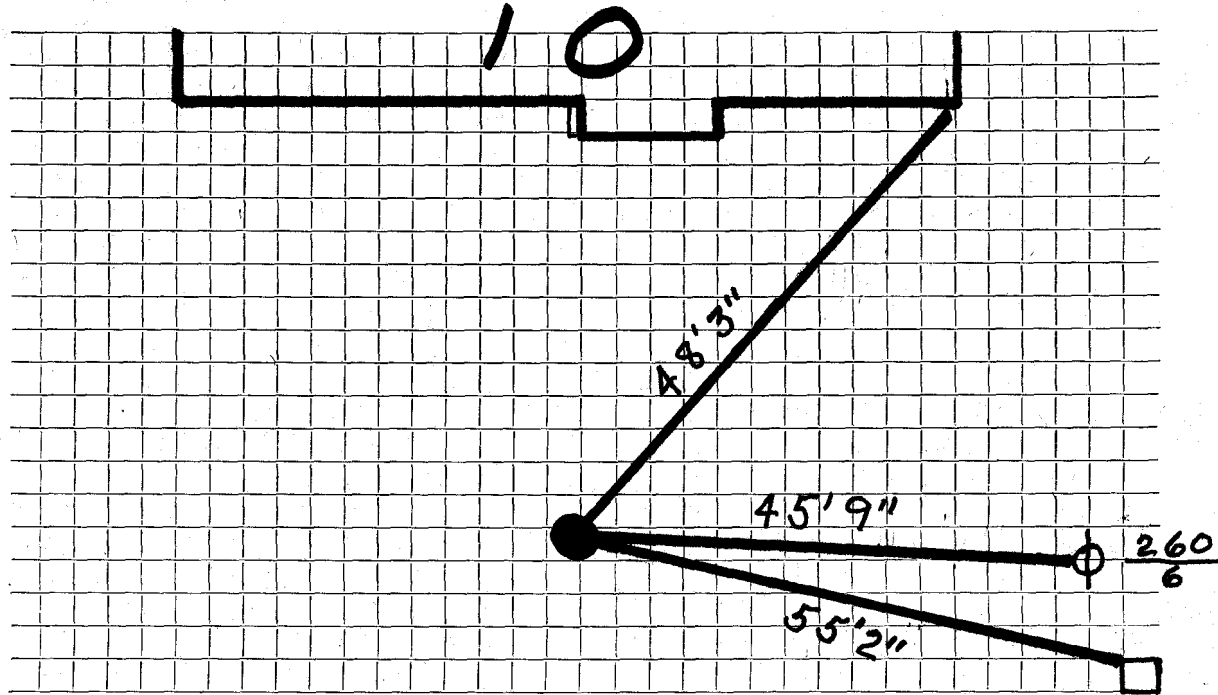

Connection made in Street. Work completed

Remarks:

.....

.....