

WATER SERVICE RECORD

Name Kelly Corp.

Service No. 261

Address 12 Scotland Rd.

Location Lexington

~~REPAIR WORK~~ - New Service

Com. 12-1-52


Date	Material	Amount	Total	Date	Amount
10/31/52	Labor	1 63		11-9-52 Deposited	10 --
	10% overhead	16	1 79	12-1-52 Refunded	(3 46)
	1 -3/4" C x 1/2 I.W.H. stop & waste	4 00		NON CHARGE	2 54
	1 hr. trucking		75	10/31/52 Labor	4 74
			6 54	20' - 3/4" copper tubing @ .34	6 80
	TRENCH DUG BY OWNER			1 -3/4" C. corp-cock	4 33
	PIPE SUPPLIED & LAID BY OWNER			1 -3/4" Cx 3/4" C. curb-cock	4 67
				1 box sand rod	3 90
3/99	1" Copper			1 -1/2 straight tail pc.	50
				1 -1/2 offset tail pc.	50
				1 hr. trucking	75
					<u>26 19</u>

DATE _____

TOWN OF LEXINGTON — BOARD OF PUBLIC WORKS

WATER DIVISION

SCOTLAND RD. Sketch of Service Here

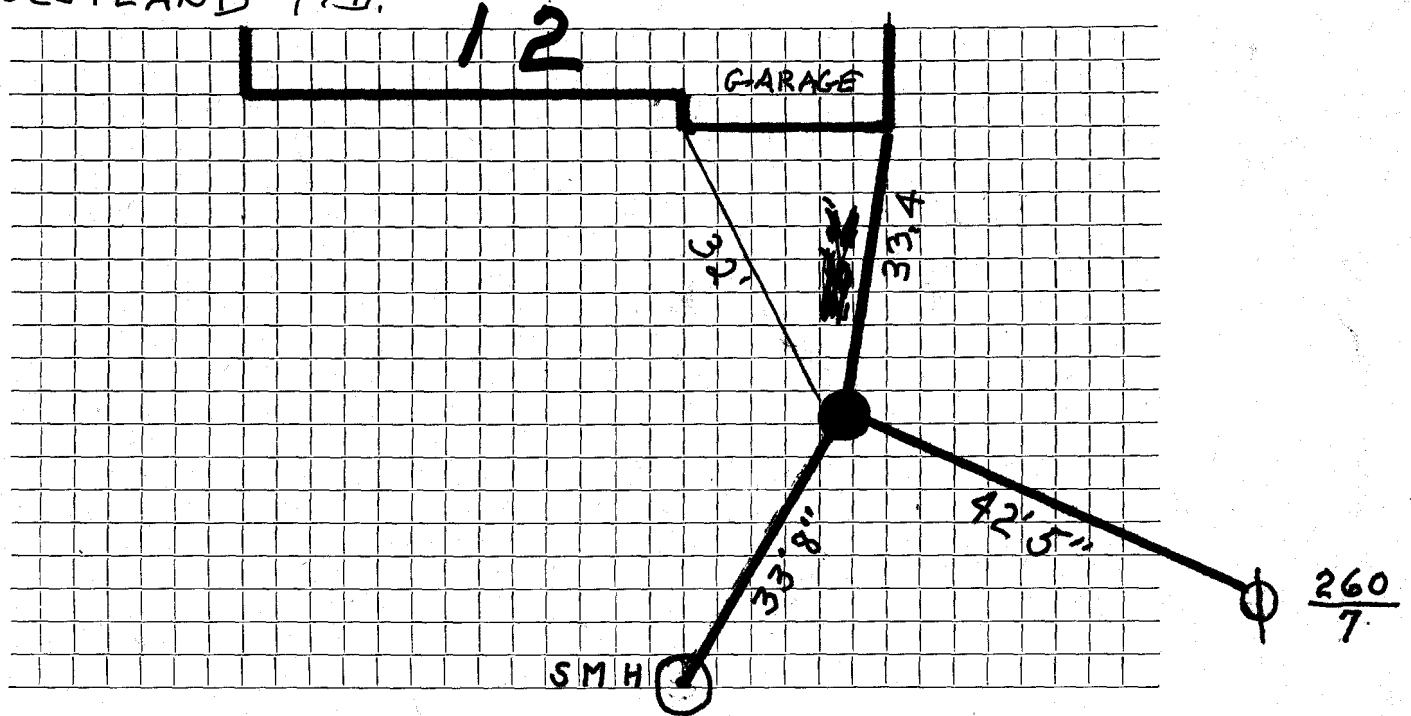

Connection made in Street. Work completed

Remarks:

.....

.....