

WATER SERVICE RECORD

Name Kelly Corp.

Service No. 262

Address 14 Scotland Road

Location Lexington

~~REPAIR WORK~~ - New Service

Cam. 12-1-52


Date	Material	Amount	Total	Date	Amount
10/28/52	Labor	1 63		10-9-52 Deposited	10 00
	10% overhead	16	1 79	12-1-52 Refunded	(3 46)
	1 -3/4" C x 1/2 I.W.H. stop & waste	4 00		NON CHARGE	6 54
	1 hr. trucking		75	10/28/52 Labor	3 83
			6 54	24' - 3/4" copper tubing @ .34	8 16
	TRENCH DUG BY OWNER			1 -3/4" C. corp-cock	4 33
	PIPE SUPPLIED & LAID BY OWNER			1 -3/4" Cx 3/4" C. curb-cock	4 67
				1 box and rod	3 90
				1 -1/2 straight tail piece	50
				1 -1/2 offset tail piece	50
				1 hr. trucking	75
					<u>26 64</u>

TOWN OF LEXINGTON — BOARD OF PUBLIC WORKS

99.6

WATER DIVISION

Sketch of Service Here

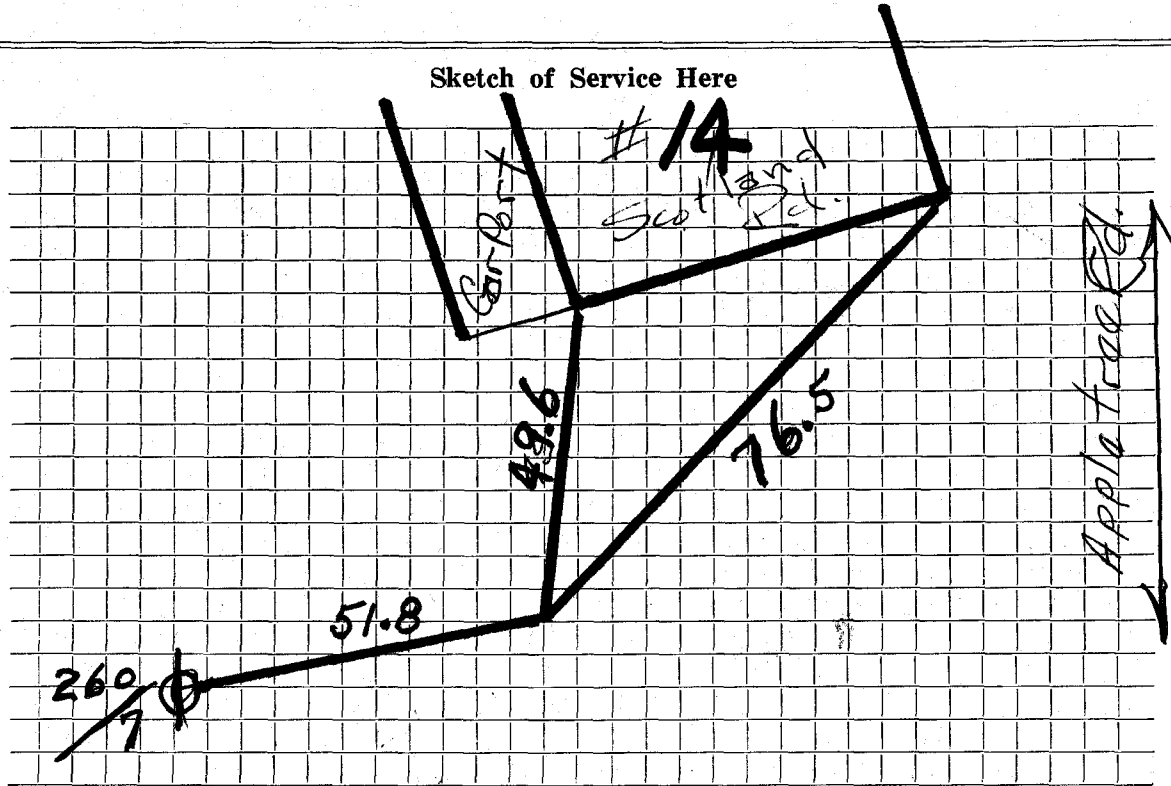

Connection made in Street. Work completed

Remarks:

.....
.....