

WATER SERVICE RECORD

Name Kelly Corp.

Service No. 253

Address 2 Scotland Road

Location Lexington

~~Repair/Alteration~~ - New Service

*Com. 12-1-52*


Date	Material	Amount	Total	Date	Amount
10/29/52	Labor	1 63		10-9-52	Deposited 10 -
	10% overhead	16	1 79	12-1-52	Refunded (3) 46
	1 -3/4" Cx 1/2 I.W.H. stop & waste		4 00		NON CHARGE 6 54
	1 hr. trucking		75	10/29/52	Labor 3 14
			6 54	12'	-3/4" copper tubing @ .34 4 08
	trench dug by owner			1	-3/4" C. corp-cock 4 33
	pipe supplied & laid by owner			1	-3/4" C x 3/4" C. curb-cock 4 67
					1 box and rod 3 90
					1 -1/2 straight tail piece 50
					1 -1/2 offset tail piece 50
					1 hr. trucking 75
					<u>21 87</u>

DATE \_\_\_\_\_

TOWN OF LEXINGTON — BOARD OF PUBLIC WORKS

**WATER DIVISION**

Sketch of Service Here

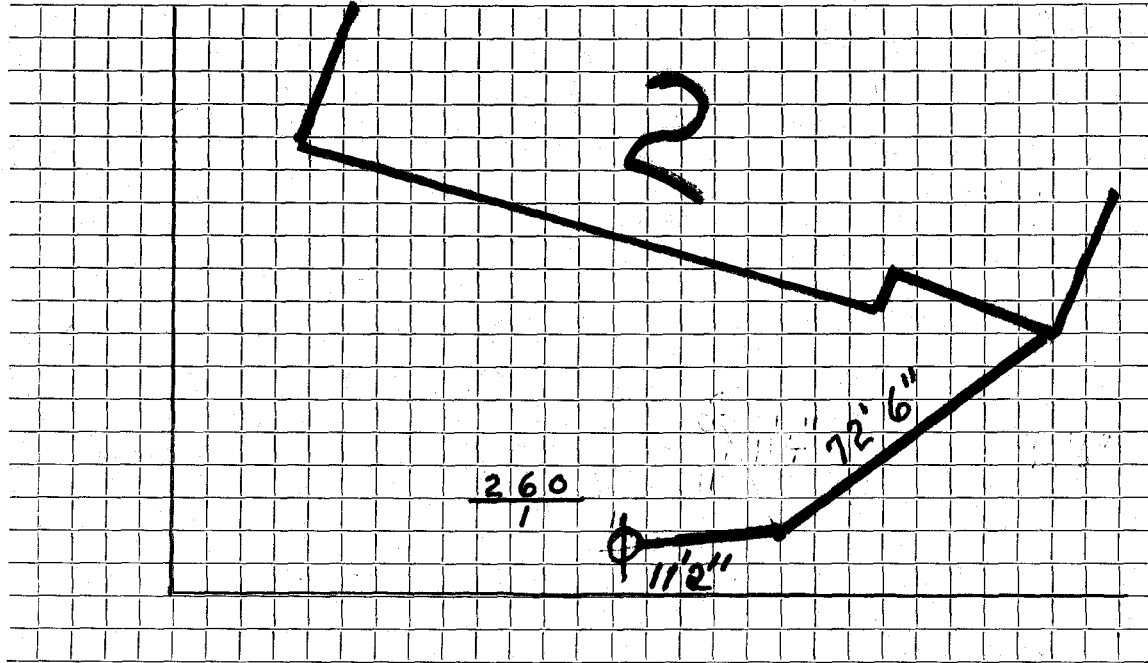

Connection made in ..... Street.                      Work completed .....

Remarks: .....  
.....  
.....