




DATE 12/12/01

TOWN OF LEXINGTON — BOARD OF PUBLIC WORKS

WATER DIVISION

Sketch of Service Here

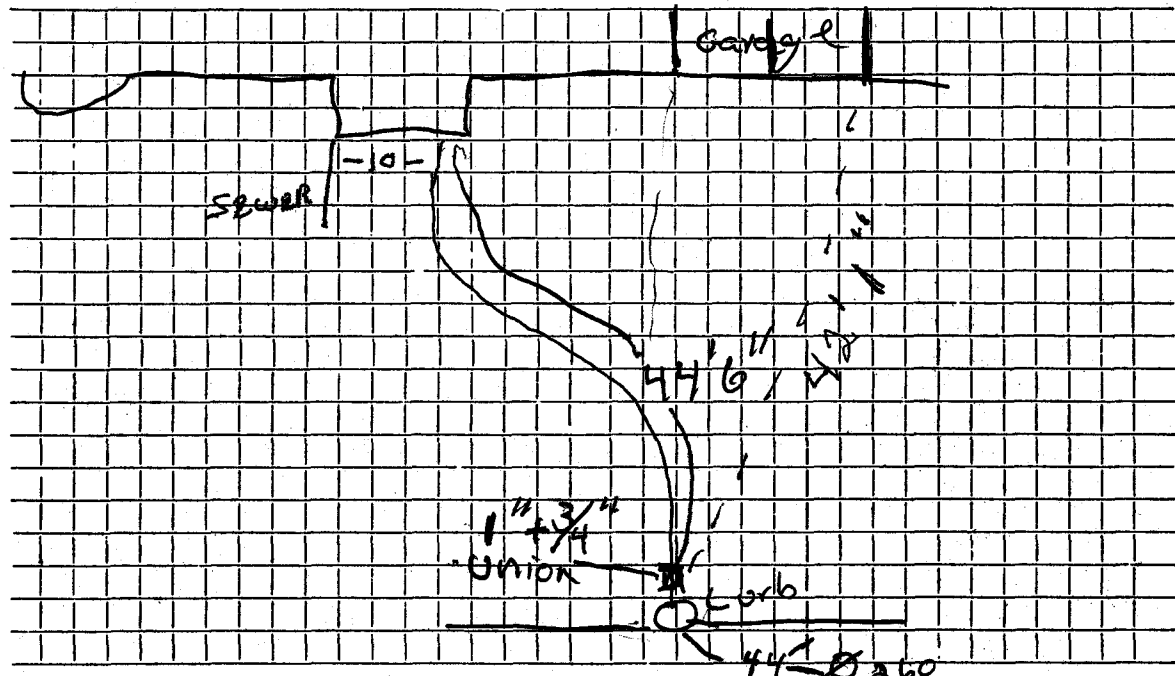

Connection made in ..SCOTTLAND... Rd... Street. Work completed 5

Remarks: INSTALLED... by... DEVLCCG