




DATE \_\_\_\_\_

TOWN OF LEXINGTON — BOARD OF PUBLIC WORKS

WATER DIVISION

Sketch of Service Here

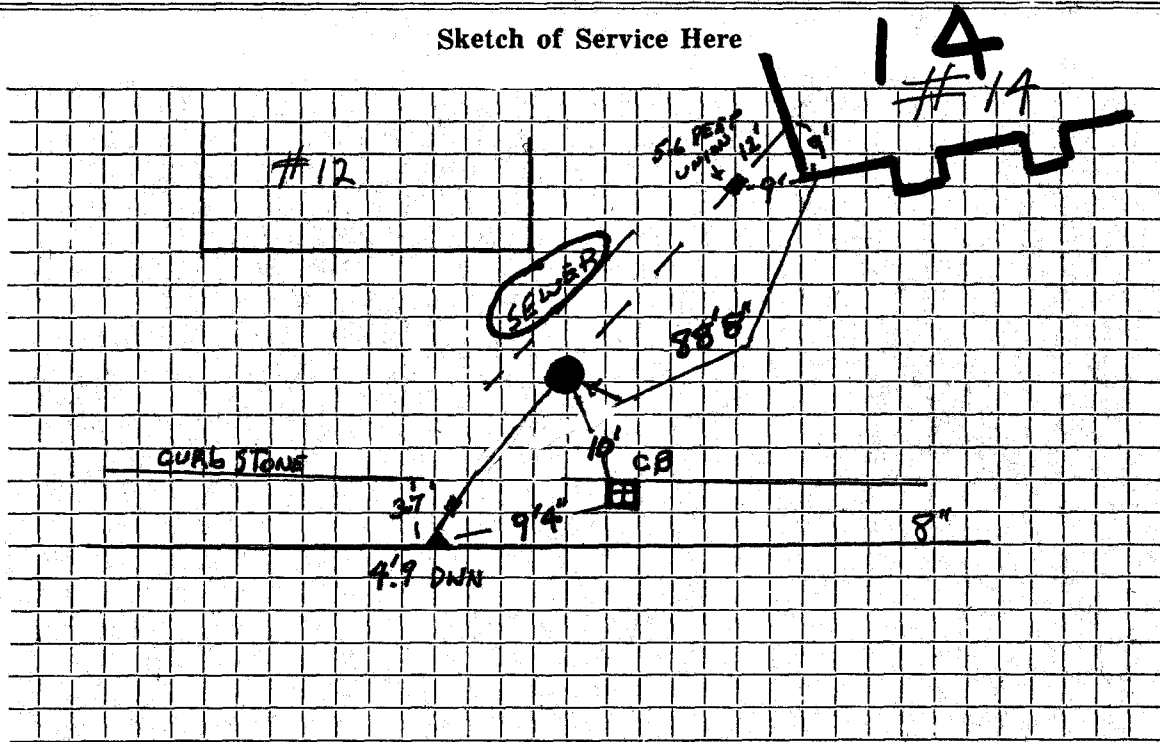

Connection made in ..... Street. Work completed .....

Remarks: 1" UNION 1 1/2' FROM CORP. COMPRESSION. Repair 7/12/95  
CURB IS IN FRONT OF HOUSE #14