


DATE _____

TOWN OF LEXINGTON — BOARD OF PUBLIC WORKS

WATER DIVISION

Sketch of Service Here

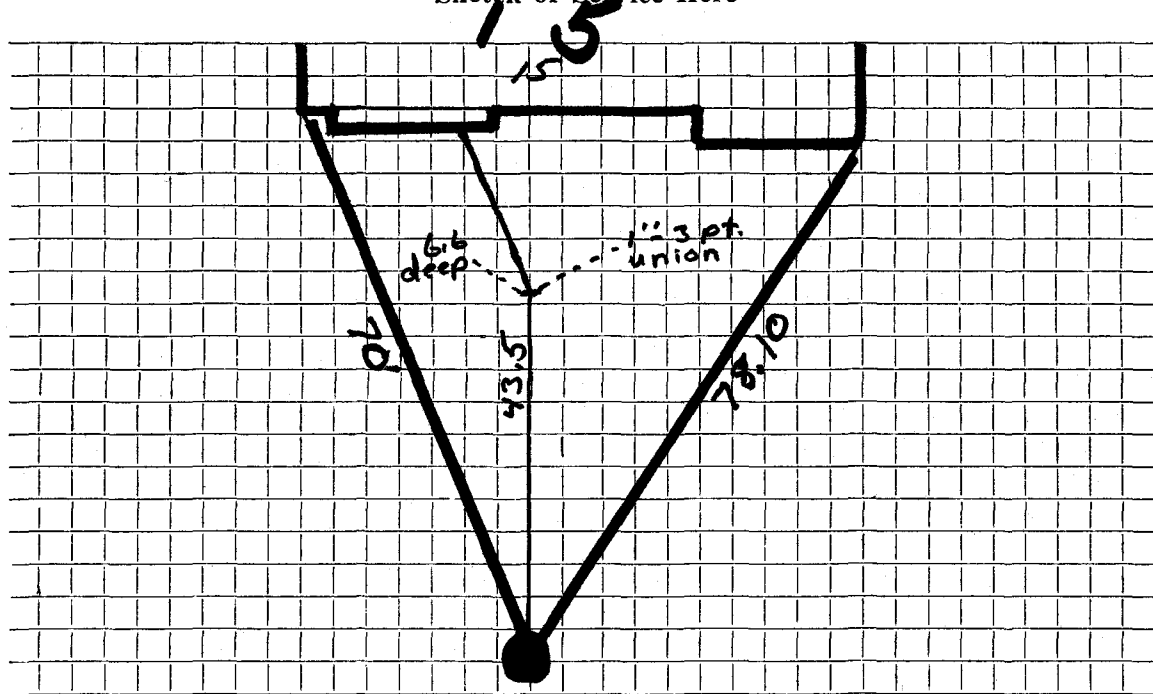

Connection made in Street. Work completed . 5-29-92

Remarks: Repair was made @ 3 part union, ... Pulled 43.5 of 1" copper and
relocated curb stop