




DATE Nov 15, 1984

TOWN OF LEXINGTON — BOARD OF PUBLIC WORKS

WATER DIVISION

4 Sketch of Service Here

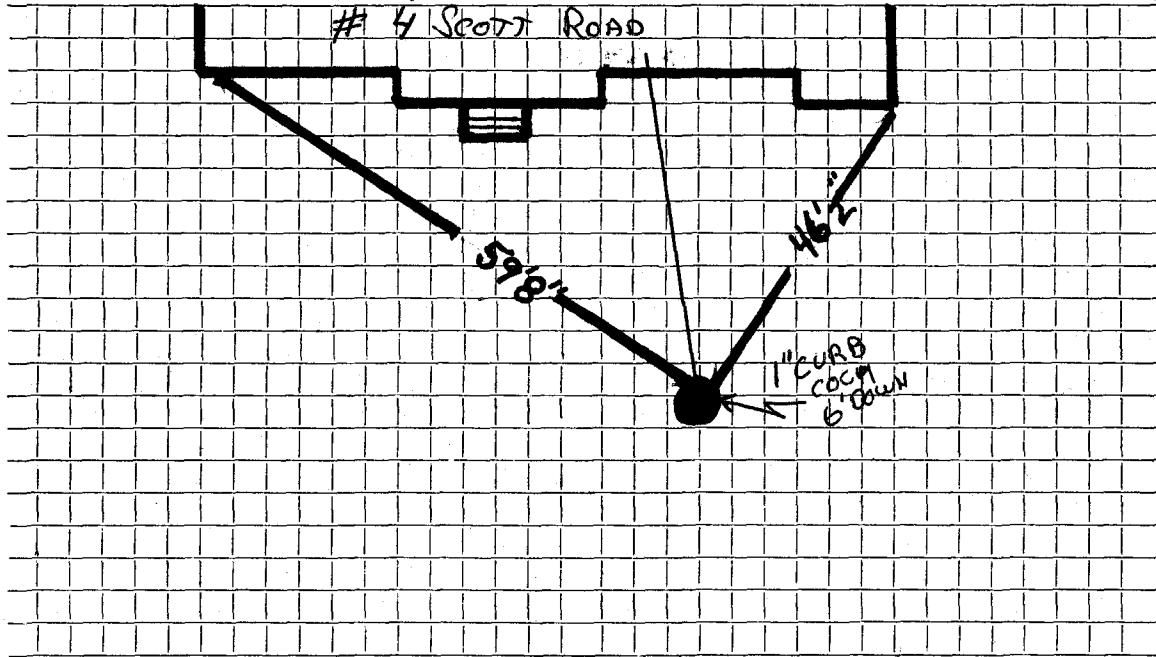

Connection made in SCOTT ROAD ..... Street. Work completed Nov 1984 .....

Remarks: WATER SERVICE CROSSES OVER SEWER SERVICE 3' OFF CURB .....