




DATE Nov 15, 1984

TOWN OF LEXINGTON — BOARD OF PUBLIC WORKS

WATER DIVISION

Sketch of Service Here

6

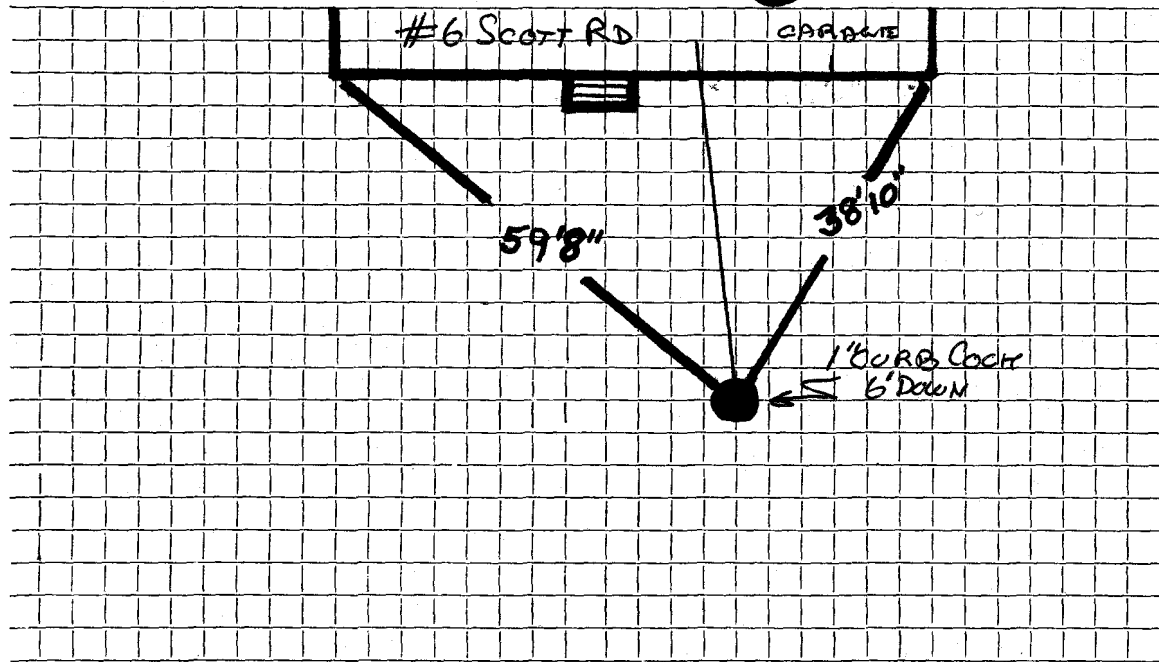

Connection made in SCOTT RD ..... Street. Work completed Nov 1984 .....

Remarks: WATER SERVICE CROSSES OVER SEWER SERVICE THREE FEET OFF CURB .....