




TOWN OF LEXINGTON — BOARD OF PUBLIC WORKS

WATER DIVISION

9 Sketch of Service Here

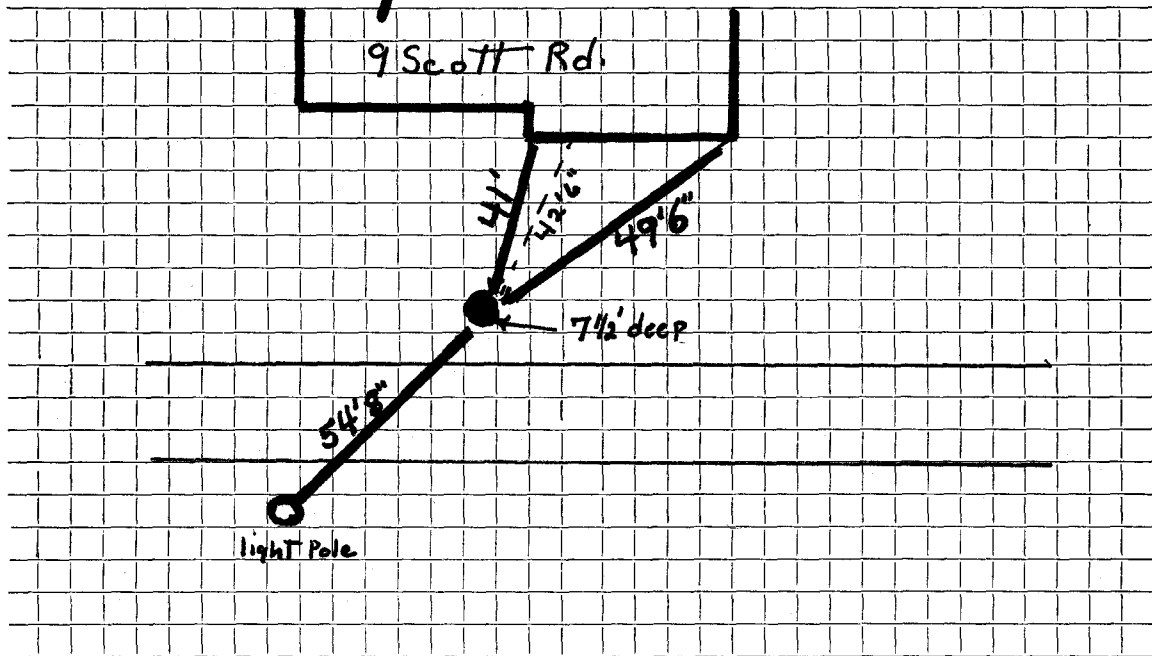

Connection made in Scott rd. 1" corr. Street. Work completed .....

Remarks: .....  
.....  
.....