




DATE \_\_\_\_\_

TOWN OF LEXINGTON — BOARD OF PUBLIC WORKS

WATER DIVISION

Sketch of Service Here

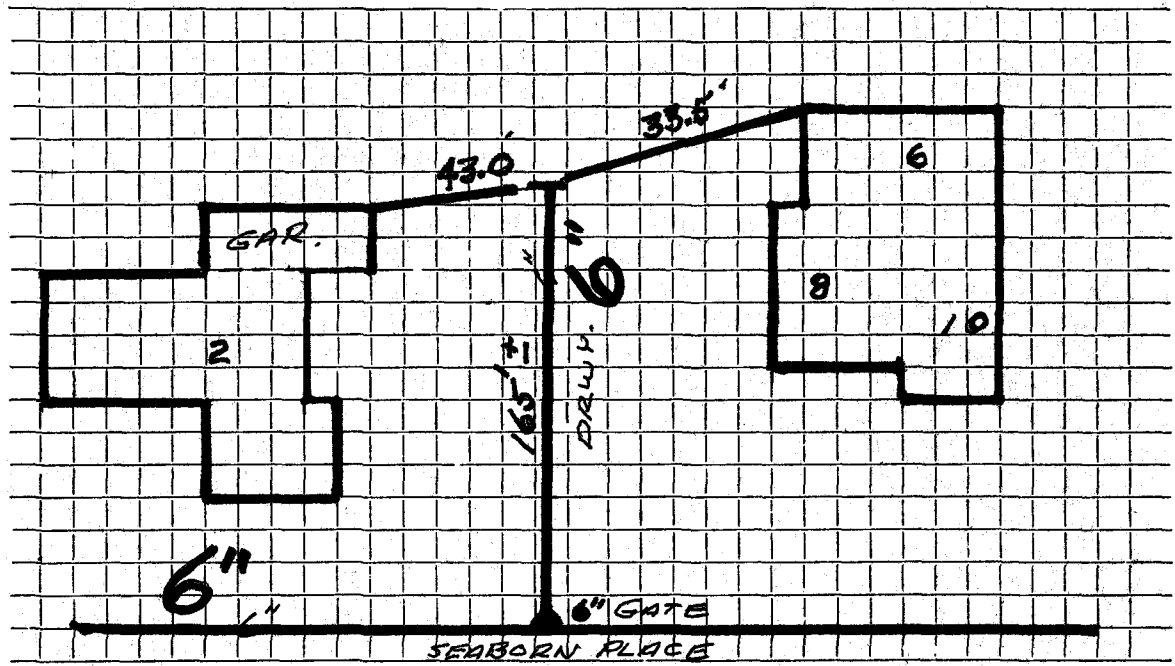

Connection made in DRWY. Street. Work completed .....

Remarks: PLUGGED END 6" MAIN .....