


DATE _____

TOWN OF LEXINGTON — BOARD OF PUBLIC WORKS

WATER DIVISION

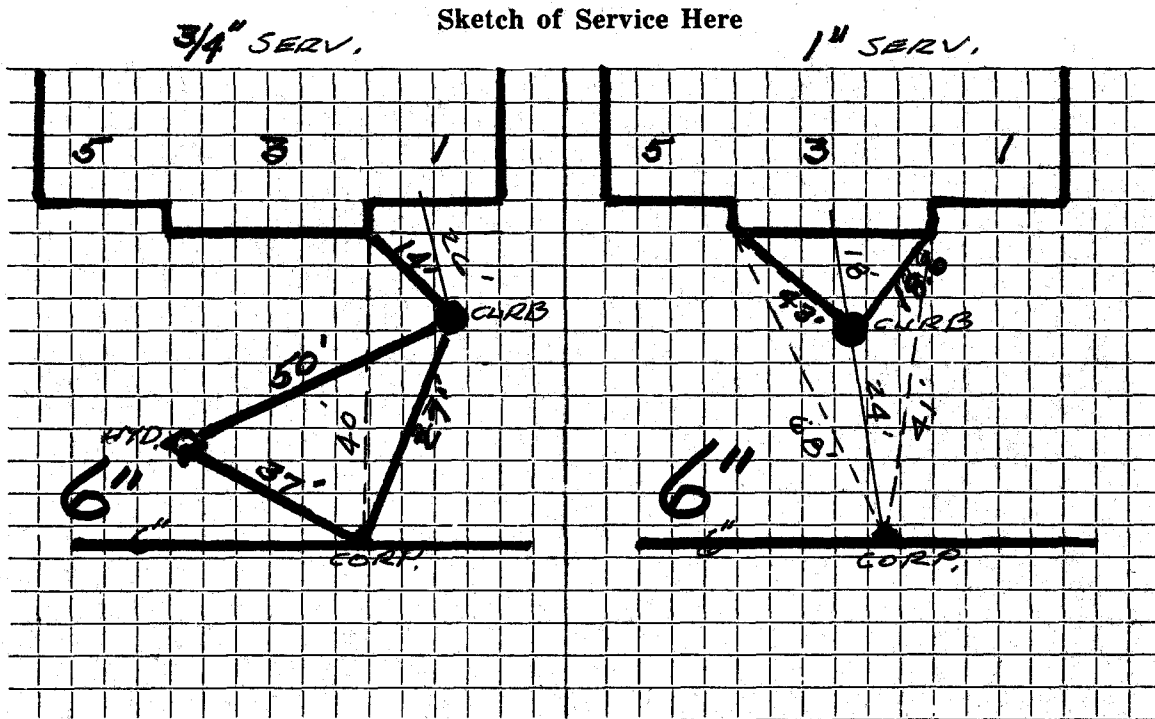

Connection made in SEABORN PLACE Street. Work completed

Remarks: 2-SERV'S

.....
.....