

WATER SERVICE RECORD

Name

Service No.

Address UNIT 14, 16, 18, & 20 SEABORN PLACE

Location FISKE COMMON


Repair—Renewal—New Service

Date	Material	Amount	Total	Date	Amount
10/77	35 LF 1" COPPER 1" CORP 1" CURB				
10/77	35 LF 1" COPPER 1" CORP. 1" CURB				

TOWN OF LEXINGTON — BOARD OF PUBLIC WORKS

WATER DIVISION

Sketch of Service Here

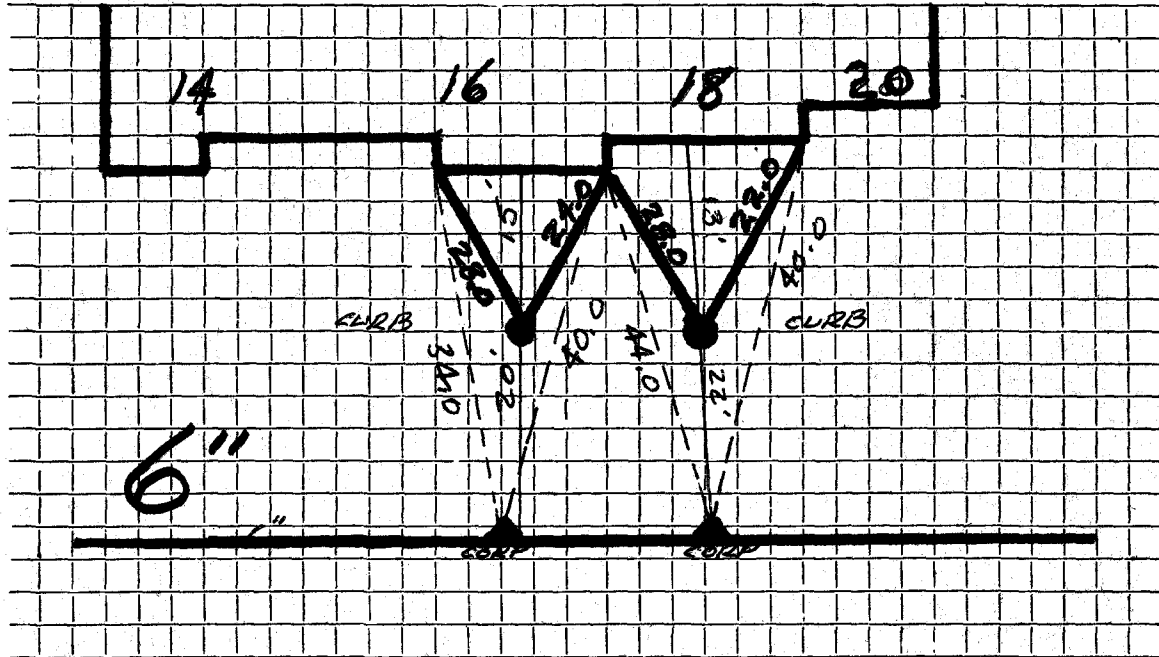

Connection made in SEABORN PLACE Street. Work completed

Remarks: 2-1" SERV'S