

# WATER SERVICE RECORD

Name

Service No.

Address *UNIT 24, 26, 28, & 30 SEABORN PLACE*

Location *FISKE COMMON*


Repair—Renewal—New Service

| Date         | Material               | Amount | Total | Date | Amount |
|--------------|------------------------|--------|-------|------|--------|
| <i>10/77</i> | <i>81 LF 1" COPPER</i> |        |       |      |        |
|              | <i>1" CORP</i>         |        |       |      |        |
|              | <i>1" CURB</i>         |        |       |      |        |
| <i>10/77</i> | <i>81 LF 1" COPPER</i> |        |       |      |        |
|              | <i>1" CORP</i>         |        |       |      |        |
|              | <i>1" CURB</i>         |        |       |      |        |

TOWN OF LEXINGTON — BOARD OF PUBLIC WORKS

**WATER DIVISION**

Sketch of Service Here

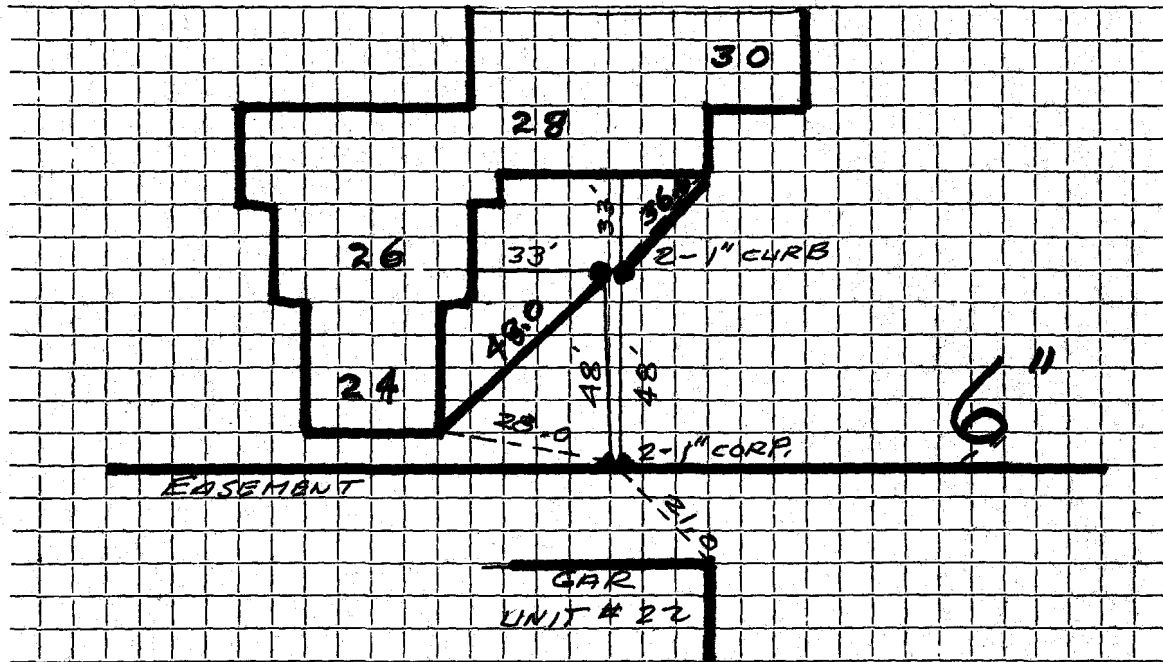

Connection made in EASEMENT ..... Street. Work completed .....

Remarks: 2-1" SERV.'S .....