


DATE _____

TOWN OF LEXINGTON — BOARD OF PUBLIC WORKS

WATER DIVISION

Sketch of Service Here

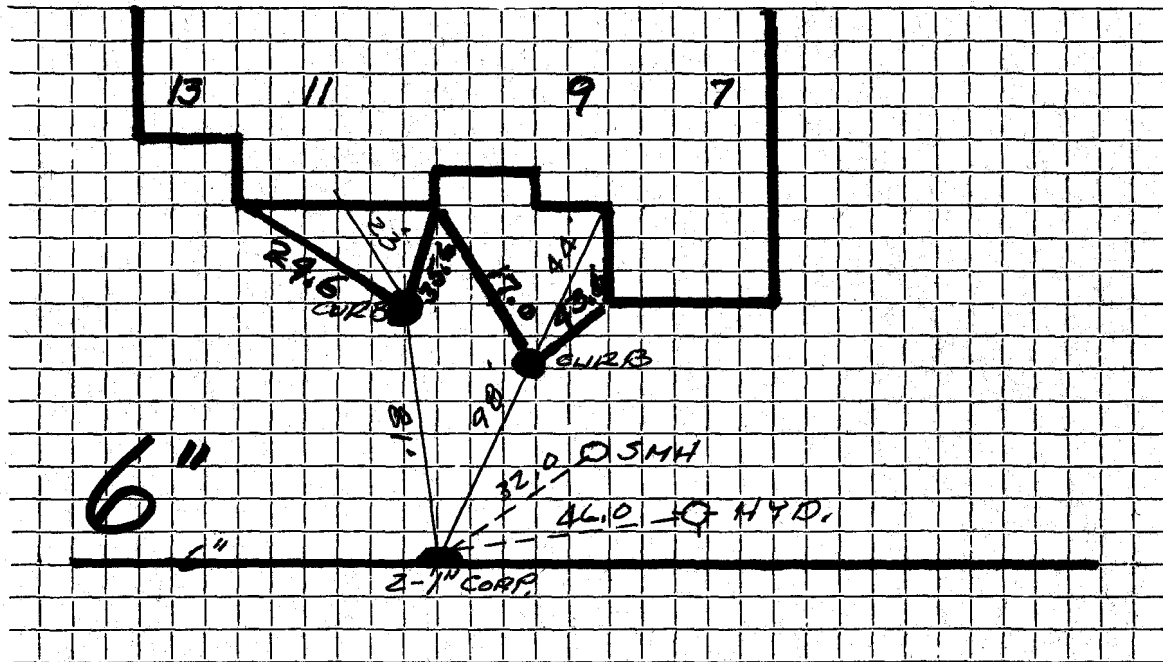

Connection made in SEABORN PLACE Street. Work completed

Remarks: 2-SERV'S