


Water Service Tie Card
TOWN OF LEXINGTON
 MASSACHUSETTS

2 Sedge Rd

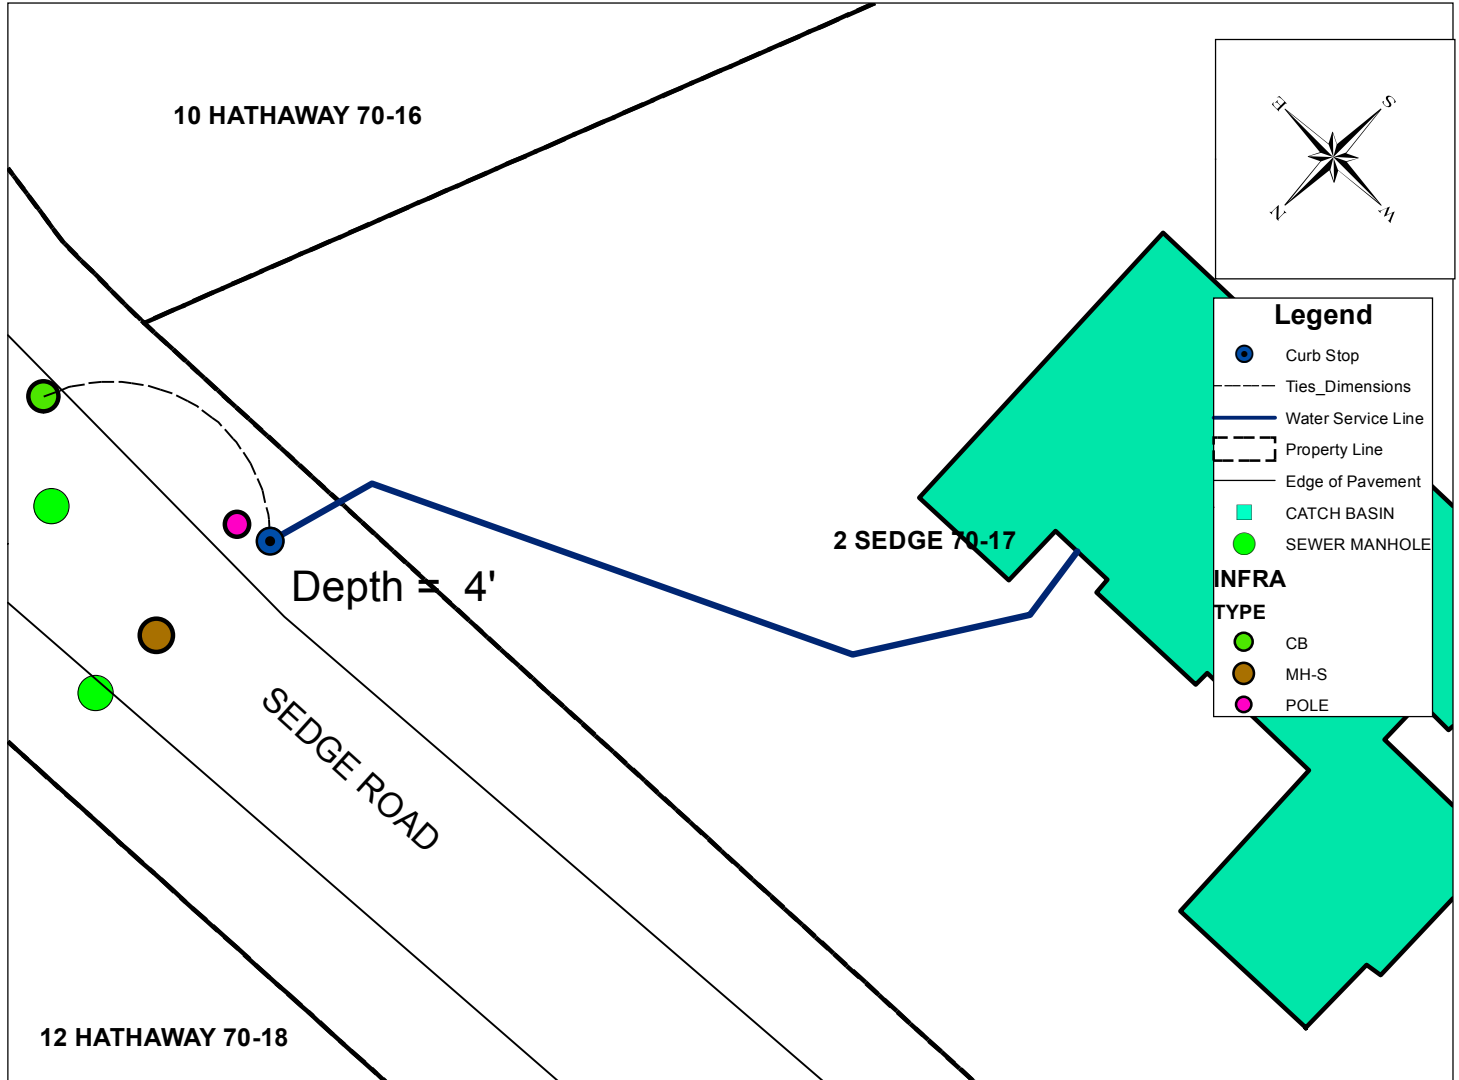

Address	Map and Lot	Permit Number	Contractor Name	Inspector
2 Sedge Rd	70-17	5872	Rose, Paul J. Excavator	dpavlik msprague
Date	Material	Depth of Cover	Amount	
4/25/2014	3/4" Copper type "k"	5.3 ft	6"	
	3/4" to 1" fitting	5.3 ft	1	
	1" Curb Valve and Buffalo Box	5.3 ft	1	
	1" Copper type "k"	4 ft	17 ft to union	
	1" Copper type "k"		63.2 ft to HSE	
Type of work completed				

New 1" water service to house from curb stop. New house on lot old house removed.