




DATE \_\_\_\_\_

# TOWN OF LEXINGTON — BOARD OF PUBLIC WORKS

## WATER DIVISION

Sketch of Service Here

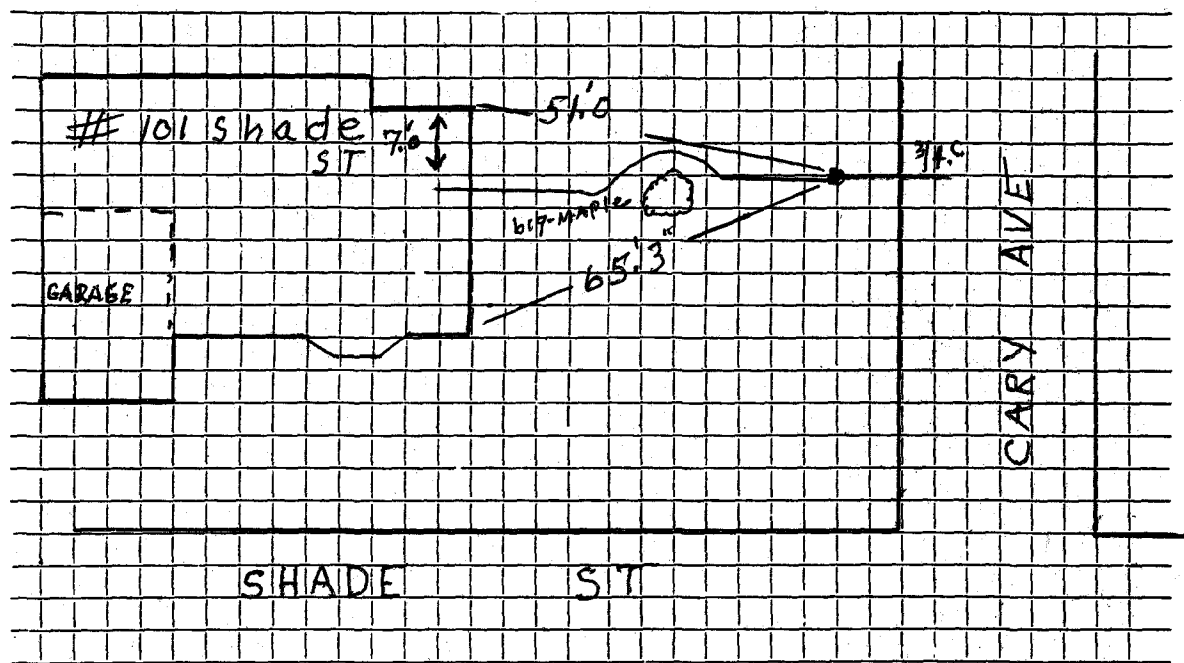

Connection made in CARY AVE Street.

Work completed 2/14/05 J. McLaughlin

Remarks: .....

.....

.....

WATER SERVICE RECORD

#2437

Name Joseph Chisholm

Service No. 51

Address 101 Shade St.

Location Lexington

LOT # 253 Cary Ave.

REPAIRS - ~~REPAIRS~~ New Service COM. 4-6-53

Date	Material	Amount	Total	Date	Amount
3/24/53	Labor	11 60		3-10-53 Deposited	75 -
	10% overhead	1 16	12 76	4-6-53 Refunded	(75)
	80'-3/4" Copper Tubing @.34	27 20			NON CHARGE 67 40
	1-3/4" Cx 1/2" I.W.H. stop & waste	4 00		1-1/2" Straight Tail Piece	50
	1-3/4" Cx 3/4" C. Union 3 parts	1 72		1-1/2" offset Tail Piece	50
	3 Hrs. Littlefield Shovel @7.00	21 00			1 00
	1 Hr. Trucking		75		
			67 43		
				<p>Service was put in to curb from Cary Ave (can attached)</p> <p>8-23-51</p> <p>25 3/4" Copper</p> <p>1 3/4" C. Corp Cock</p> <p>1 3/4" C. X 3/4" C. Curb Cock</p> <p>1 Box + Rod</p>	

