

**WATER SERVICE RECORD**

Name *Charles Bourque*

Service No.

Address *109 SHADE ST.*

Location

Repair—Renewal—New Service

*McLaughlin #0270*


Date	Material	Amount	Total	Date	Amount
<i>8/13/93</i>	<i>167 LF 3/4" COPPER</i>				
	<i>3/4" UNION</i>				
				<i>10-8-51'</i>	
				<i>15' 3/4" Copper</i>	
				<i>1 3/4" C. Corp Cock</i>	
				<i>1 3/4" C. X 3/4" C. Curb Cock</i>	
				<i>1 Box + Rod</i>	

DATE 8/9/94

TOWN OF LEXINGTON — BOARD OF PUBLIC WORKS

WATER DIVISION

Sketch of Service Here

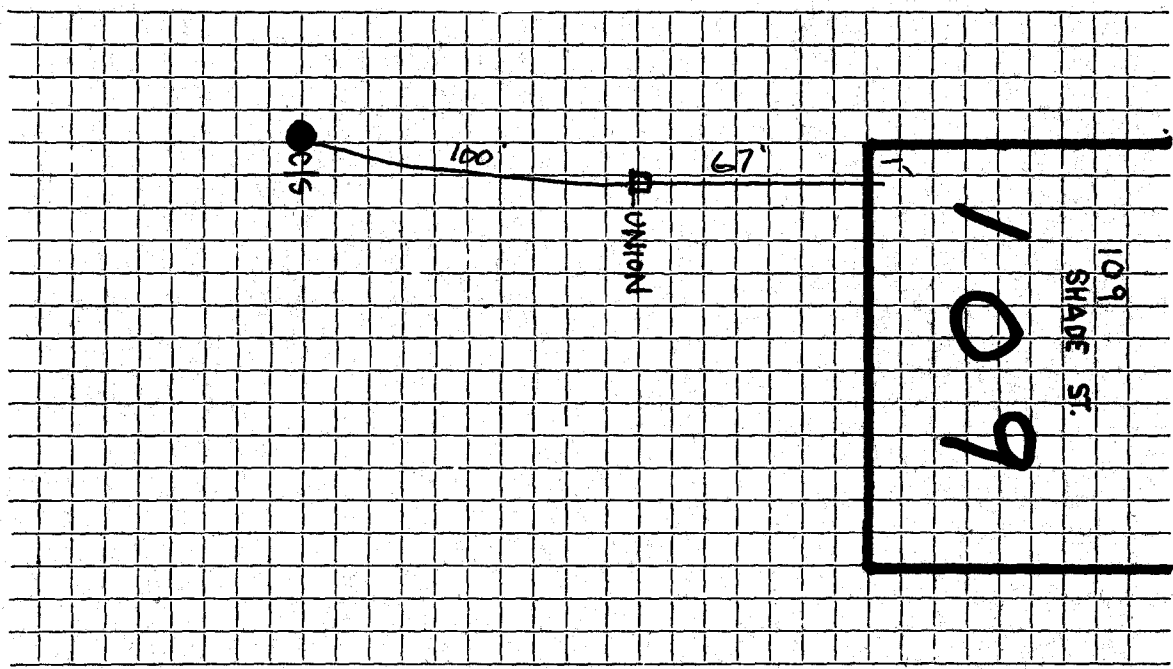

Connection made in ..... Street. Work completed .....

Remarks: Original Service 10-8-51 .....