


TOWN OF LEXINGTON — BOARD OF PUBLIC WORKS
WATER DIVISION

Sketch of Service Here

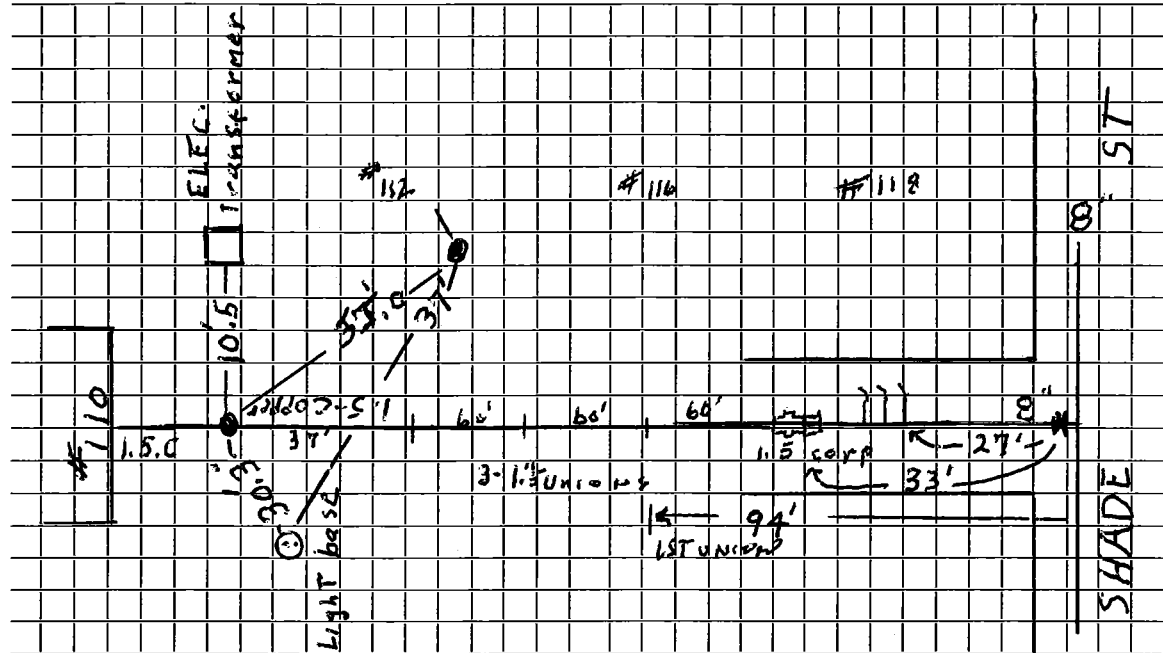

Connection made in Street. Work completed

Remarks: 8" CAP. Taped Cap w/ 1.5" corp. 1.5" Curb ... 1.5" between Corp's

.....

.....