


TOWN OF LEXINGTON — BOARD OF PUBLIC WORKS

WATER DIVISION

Sketch of Service Here

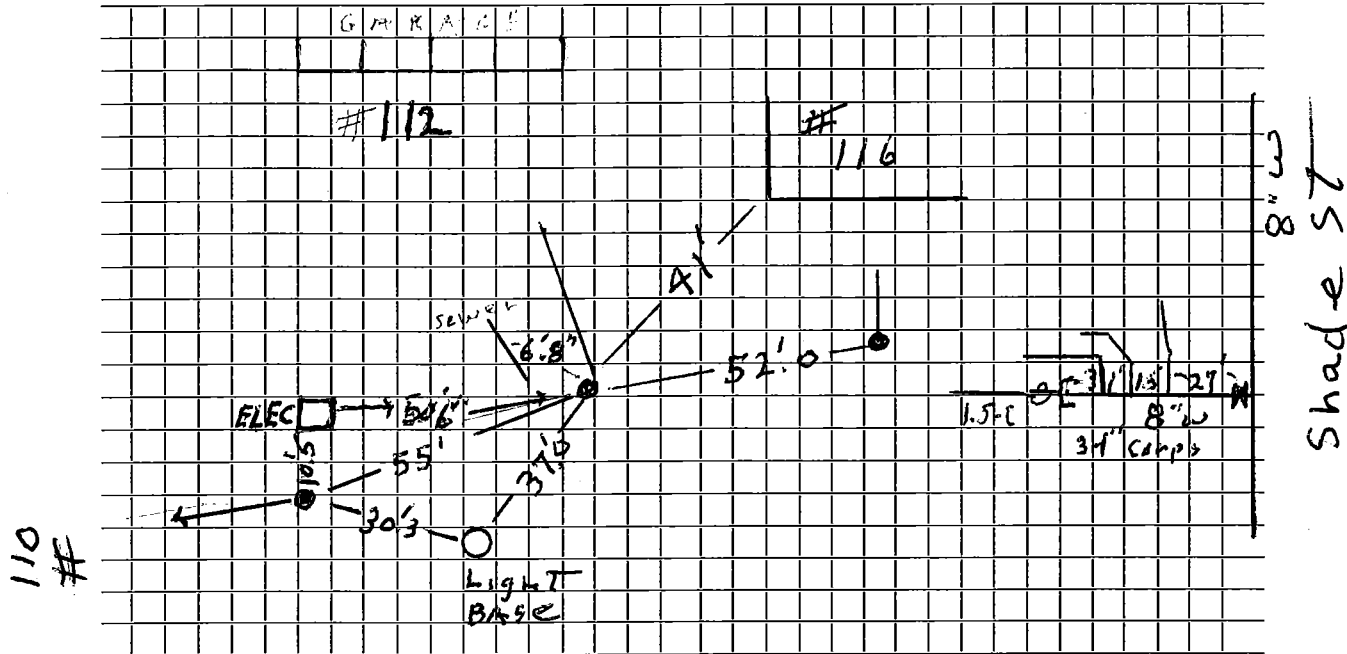

Connection made in Journey's End Street. Work completed

Remarks: 3-1" Corp's / 1-1.5" Corp

.....

.....