

WATER SERVICE RECORD

476

Name Arthur C. Weiss

Service No. 8

Address 115 Shade Street

Location Lexington, Mass.

~~Repair~~ ~~Renewal~~ - New Service Com. 5-21-51


Date	Material	Amount	Total	Date	Amount
3-16-51	Labor	2 30	2 30	Jan 8 '51	70 00
	10% Overhead		23		
	78' - 3/4" Copper Tubing @.36	28 08			61 08
	1 - 3/4"C x 1/2" I.W.H. S'W	4 00		3-21-51	Labor
	1 - 3/4"C x 3/4"C Union (3pts)	1 72			15' - 3/4" Copper Tubing @.36
	Littlefield Shovel 2 hrs. @7.00	14 00			1 - 3/4"C Corp-cock
	Trucking 1 hr. @.75		75		1 - 3/4"C x 3/4"C Curb-cock
	Patching 10 x 3		10 00		1 - Box & Rod
			61 08		1 - 1/2" Offset Tail Piece
					1 - 1/2" Straight Tail Piece
					Littlefield Shovel 1 hr. @ 7.00
					Trucking 1 hr. @.75
					46 80

DATE _____

TOWN OF LEXINGTON — BOARD OF PUBLIC WORKS

WATER DIVISION

Sketch of Service Here

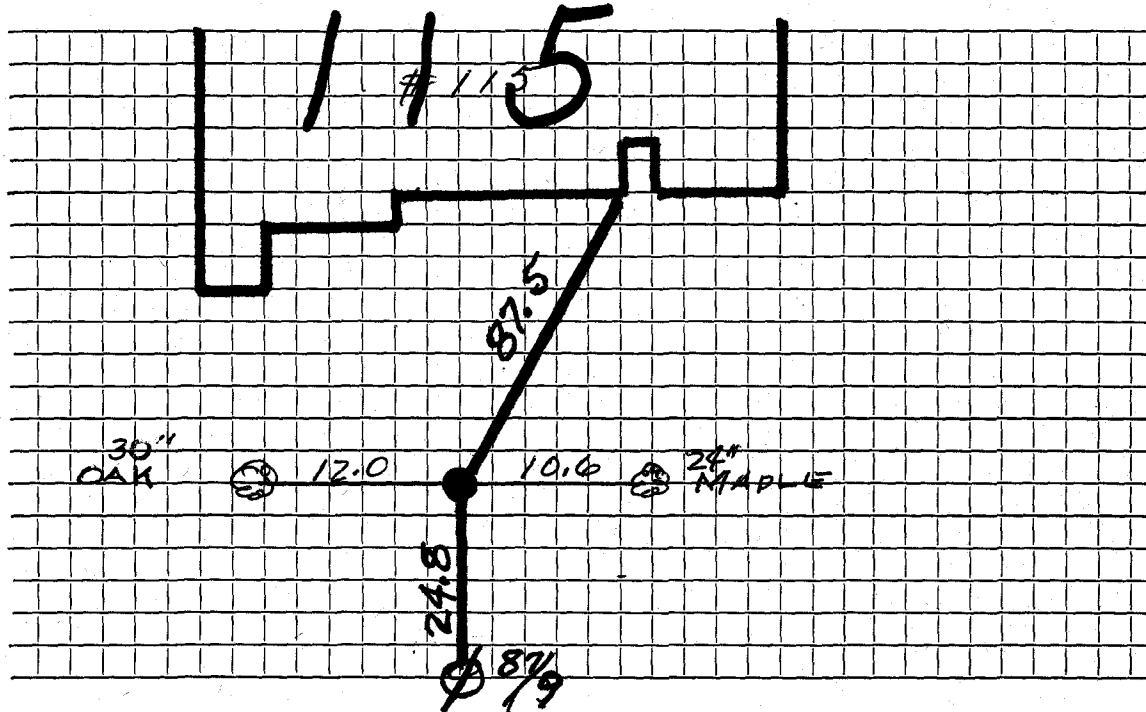

Connection made in Street. Work completed

Remarks:

.....

.....