

Name Lawrence Dargie

Service No. 177

#4861

Address 121 Shade Street

Lexington, Mass.

Location 121 Shade Street

Kind of Pipe

Size

Size of Main

~~XXXXXX~~ New Service

Com. 11-8-49

Location

Date	Material	Amount	Total	Date	Amount
Oct. 4, '49	Labor	4 80	4 80	Sept 26 '49	6 00
	10% Overhead		48	Nov 19 '49	10 25
	60' - 3/4" Copper Tubing @.24	14 40	14 40		No Charge
	1 - 3/4" C x 1/2" I.W.H. S&W	3 29	3 29	Oct. 4, '49	Labor
	Littlefield Shovel 2 hrs. @ 7.00	14 00	14 00		25' - 3/4" Copper Tubing @.24
	Trucking 1 hr. @.75	75	75		1 - 3/4" C Corp-cock
	Patching 12 x 3	12 00	12 00		1 - 3/4" C x 3/4" C Curb-cock
			49 72		1 - Box & Rod
					1 - 1/2" Offset Tail Piece
					1 - 1/2" Straight Tail Piece
					Littlefield Shovel 1 1/2 hrs. @7.00
					Trucking 1 hr. @.75
	Labor				33 54

DATE _____

TOWN OF LEXINGTON - BOARD OF PUBLIC WORKS

WATER DIVISION

The undersigned applies for a supply of water at No..... St. and hereby agrees to comply with the rules and regulations as now, or at any future time, established by the Board of Selectmen.

Am't of Estimate \$.....


Owner

Am't Paid \$.....

Address

Builder

Sketch of Service Here

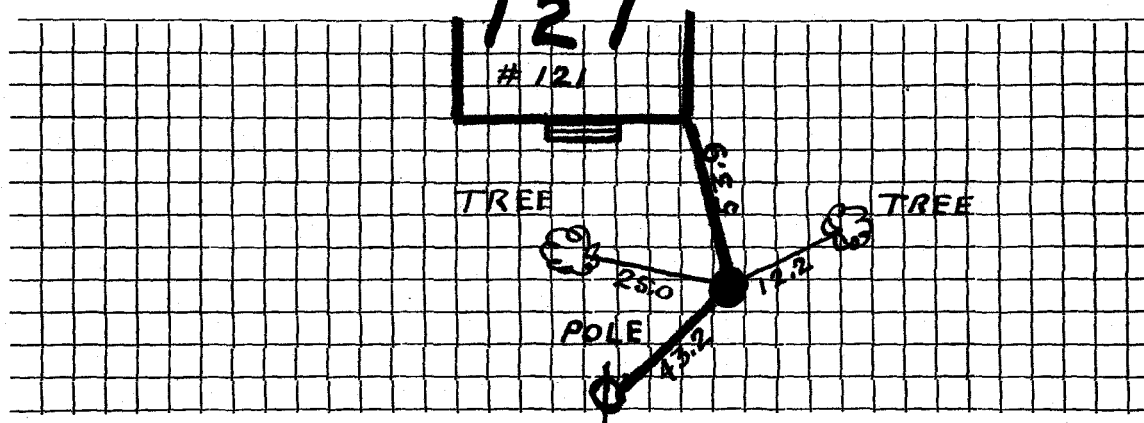

Connection made in Street.

Work completed19

Remarks: