

WATER SERVICE RECORD

Name _____

PERMIT
~~SEARCH~~ No.

1592

Address

125 SHADE ST

Location


Repair—Renewal—New Service

DATE 11-30-01

TOWN OF LEXINGTON — BOARD OF PUBLIC WORKS

WATER DIVISION

Sketch of Service Here

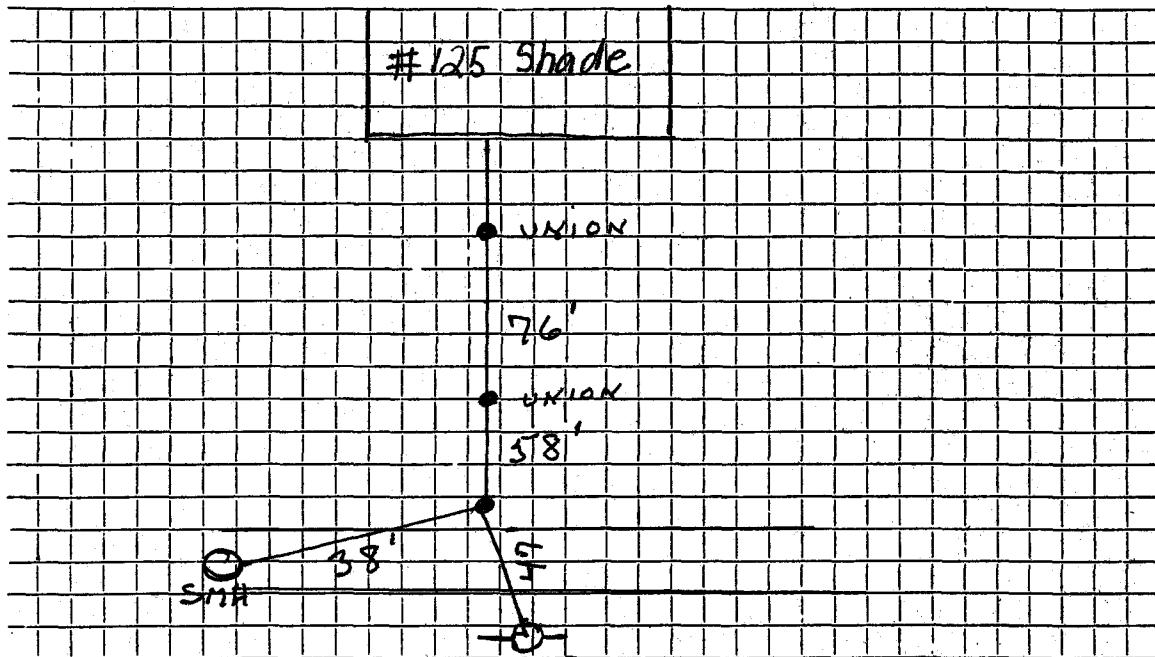

Connection made in S.H.A.D.E Street. 8/8 Work completed 11-1-01.....

Remarks: F.N.S.T.A.L.L.E.D. bY T.O.C.C.I. E.X.C.A.V.A.T.I.O.N.....